



FILED
GREENVILLE CO. S. C.
FEB 28 4 48 PM '83
DONNIE S. TANKERSLEY
R.M.C.

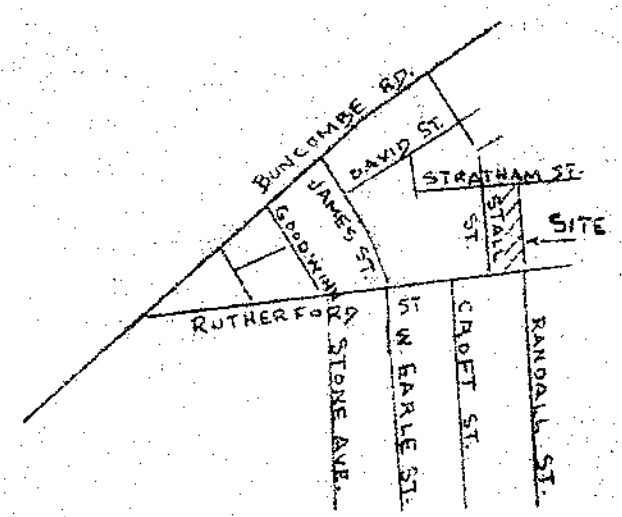

LOCATION MAP

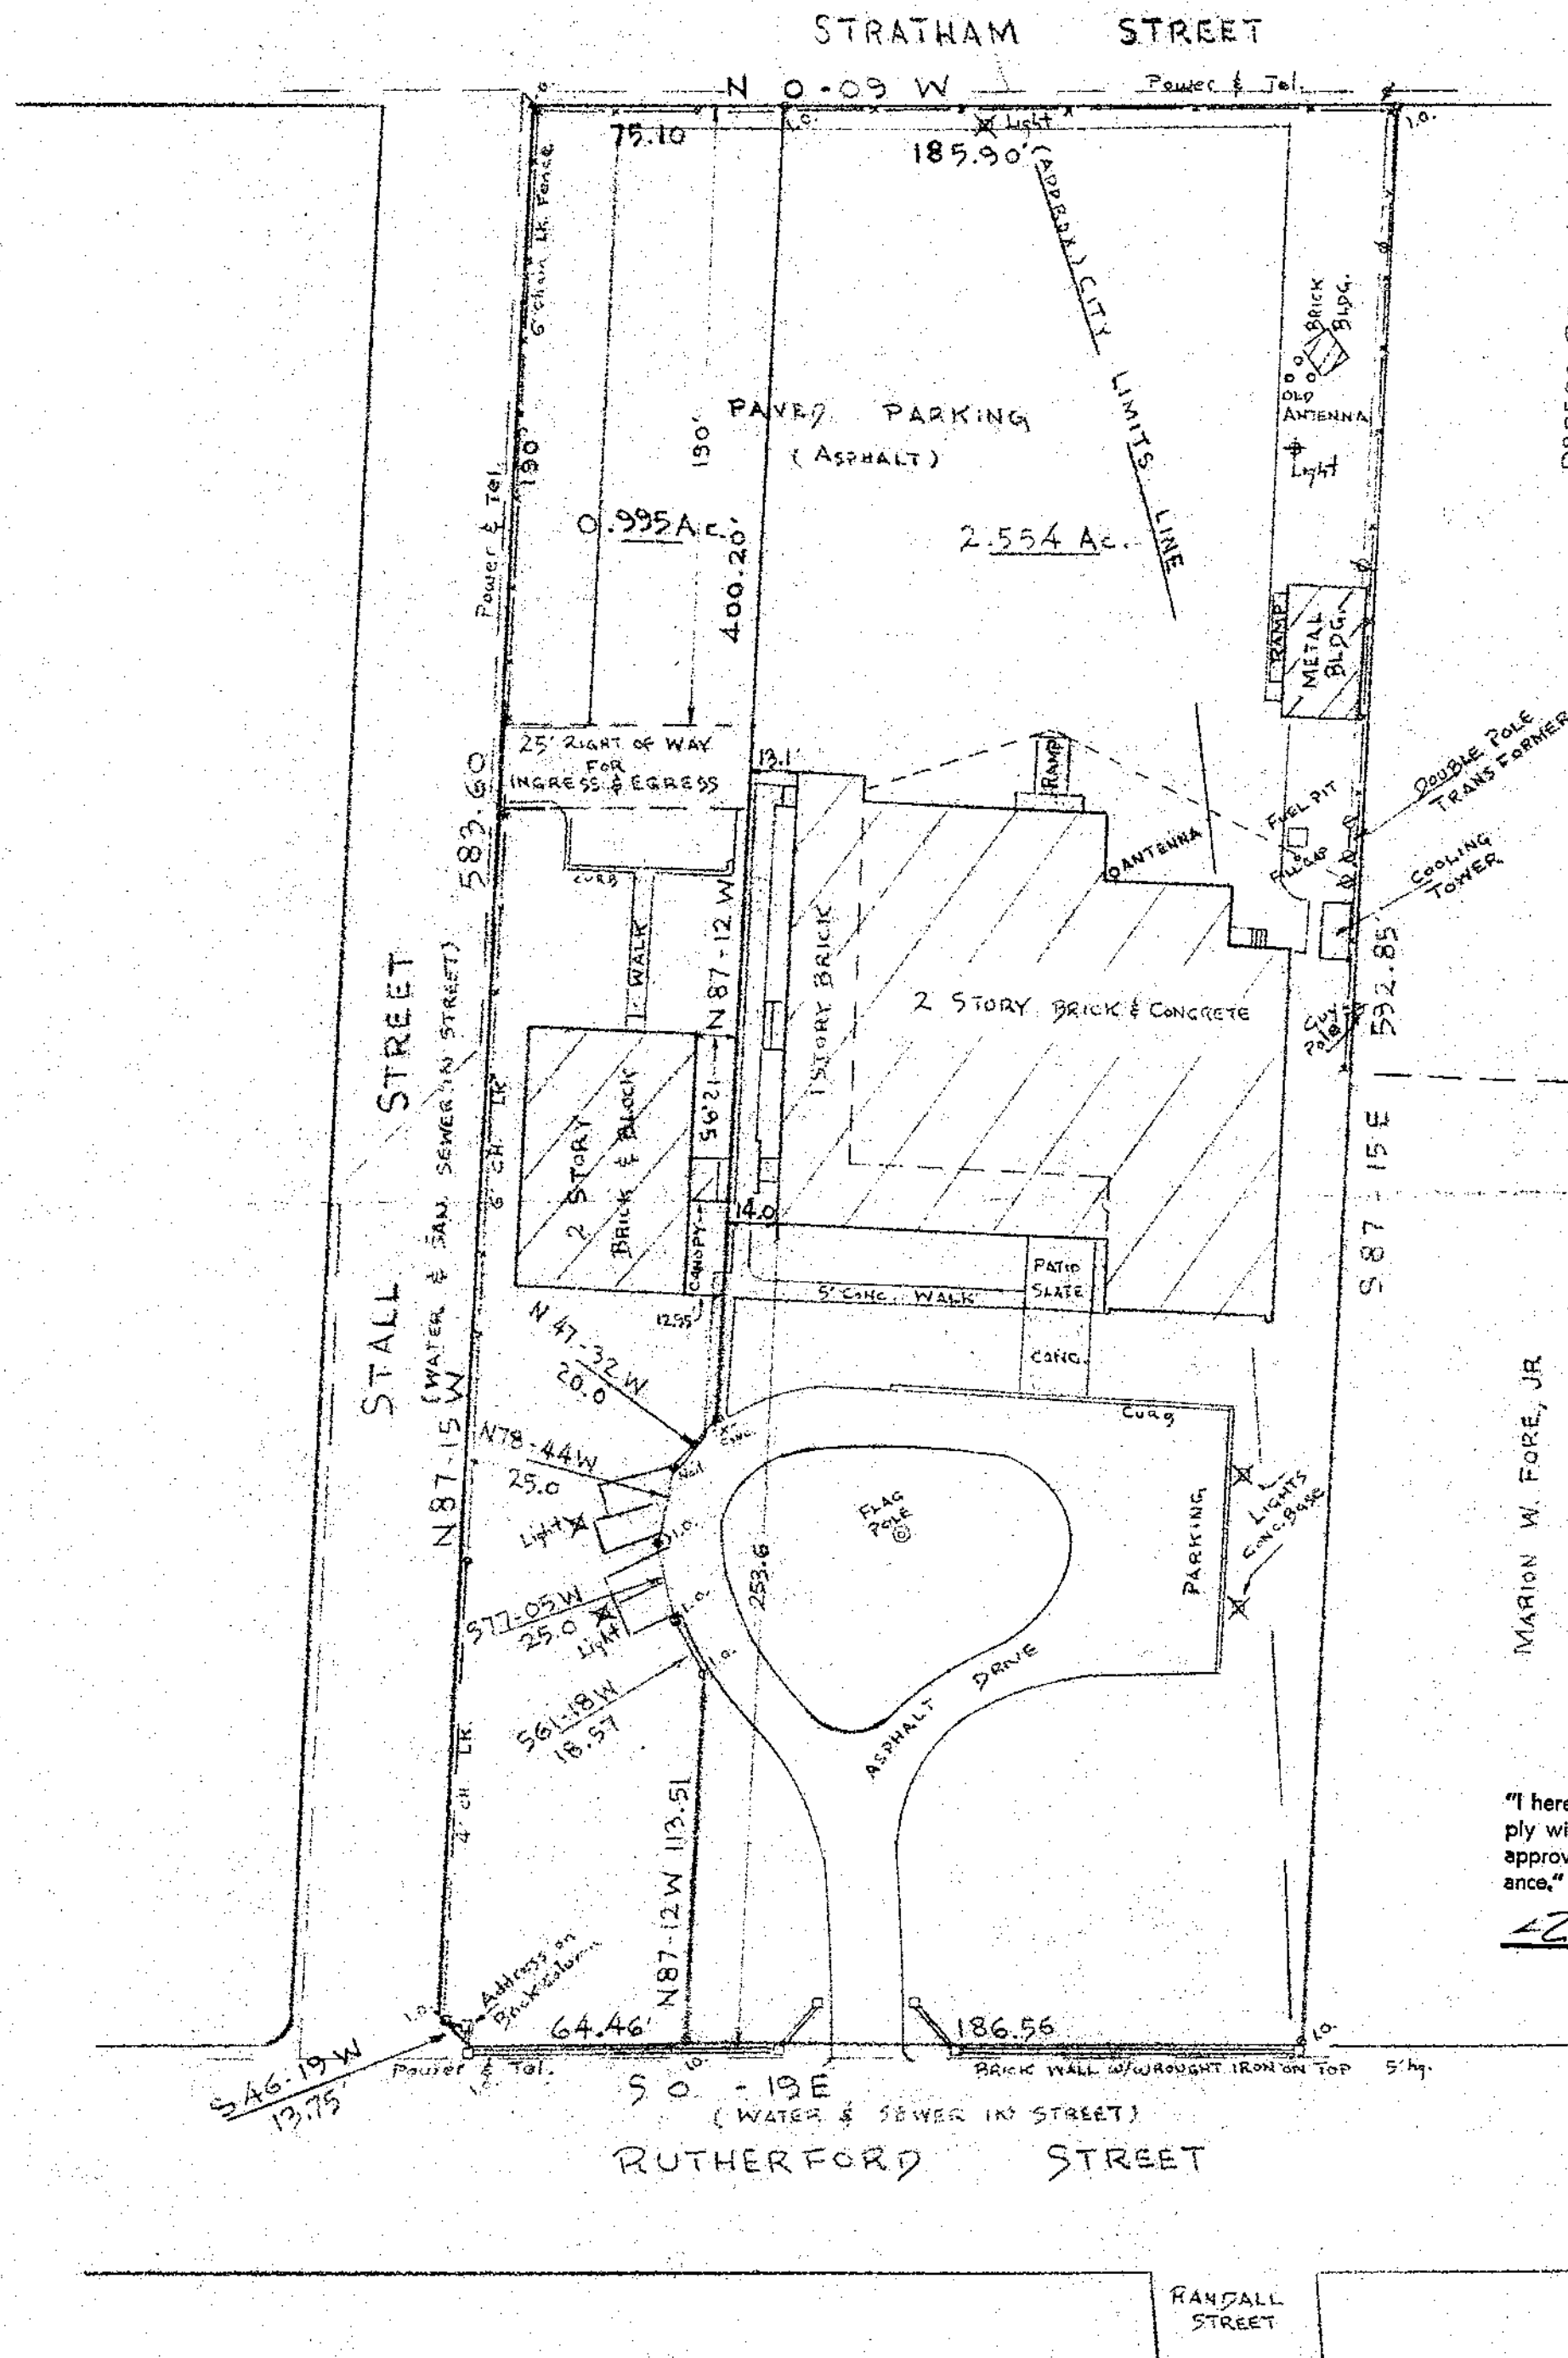

ORDERS REALTY
CO., INC.

MARION W. FORE, JR.

SUMMARY

CERTIFICATE OF APPROVAL FOR RECORDING

"I hereby certify that the subdivision plat shown hereon has been found to comply with the Subdivision Regulations for Greenville County and that it has been approved for recording in the office of the County Register of Mesne Conveyance."

12-25-83
DATE

F. James Forbes
DIRECTOR OF PLANNING
GREENVILLE COUNTY PLANNING COMMISSION

9-J-66 21435

FEB 28 1983

SURVEY FOR
MULTIMEDIA INC AND KSDK INC.
GREENVILLE, S.C.
SCALE 1" = 50' FEB 18, 1983

PIEDMONT SURVEYORS
GREENVILLE, S.C. FEB 28 83 004

5.00 CD

HEREBY CERTIFY THAT THE MEASUREMENTS AS SHOWN ARE CORRECT AND THERE ARE NO ENCROACHMENTS OR PROJECTIONS OTHER THAN SHOWN
James D. Cain
R.L.S. No. 3320

1.0. (Iron PIN 24)