

MICROFILMED

PADDOCK PLACE

HARNESS TRAIL

N 66° 15' E  
173.6

OLD I. P.

OLD I. P.

CONC. DR.

40' BUILDING LINE

ONE STY. FR. RES.

N 37° 31' W  
277

282.2  
S 09° 49' E

HERITAGE LAKES SUBD.


9

8

20' UTILITY EASEMENT

OLD I. P. 40 OLD I. P.  
S 72° 54' W

CHANDLER

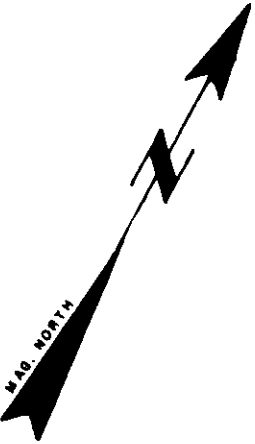

DEC 17 4 45 PM '82  
DONNIE S. TANKERSLEY  
R.M.C.

DEC 17 1982

14877

9-K-15

THIS IS TO CERTIFY THAT ON THIS DATE I SURVEYED THE PROPERTY SHOWN HEREON AND THE LINES ARE AS SHOWN; THAT THE BUILDING(S) OR WALL(S) DO NOT ENCR OACH ON THE ADJACENT PROPERTY, AND THAT THE BUILDING(S) OR WALL(S) OF THE ADJACENT PROPERTY DO NOT ENCR OACH ON THIS PROPERTY EXCEPT AS SHOWN. I CERTIFY THAT THE RATIO OF PRECISION OF THE FIELD SURVEY IS 1/2500 AS SHOWN HEREON AND THE AREAS WERE DETERMINED BY THE D. M. D. METHOD OF CALCULATION; AND THAT THIS PROPERTY ~~IS~~(IS NOT) IN ANY FLOOD AREA

REF. PLAT BOOK 6H, PP. 016.

REF. DEED BOOK 1112, PP. 586.

SURVEY FOR

**LAWRENCE B. JONES**

LOCATED NEAR SIMPSONVILLE - HERITAGE LAKES SUBD.

COUNTY: <b>GREENVILLE</b>	COUNTY BLOCK MAP: 206-539.4-1-8	STATE: <b>SOUTH CAROLINA</b>
DATE: DECEMBER 15, 1982	FIELD CHIEF: B. E. H.	DRAWN BY: L. B. M.
REVISED:		

SCALE 1" = 40'



WOLFE & HUSKEY, INC. ENGINEERING and SURVEYING  
P O BOX 35 - LYMAN, S. C. 29365

MEMBER OF THE S. C. SOCIETY OF PROFESSIONAL LAND SURVEYORS NO. 4785

FILED  
DEC 17 4 45 PM '82  
DONNIE S. TANKERSLEY  
R.M.C.  
2 DEC 17 1982  
466  
3.00CI

57-7-25