


This is to certify that on January 10,1983, I surveyed the property shown on this plat, known as Lot 18 on Plat of Del Norte Estates, Sheet 2, recorded in the RMC Office of Greenville County in Plat Book WWW on Pages 32 & 33, and that the property lines, walls and buildings are as shown ereon; that the building located on said lot does not encroach or project on adjacent streets or property, and that no adjacent walls or buildings encroach or project on said premises, and that no utility lines cross this property except as shown hereon. This property is not located in a designated flood hazard area.

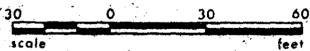



## STATE OF SOUTH CAROLINA GREENVILLE COUNTY

DEL NORTE ESTATES SHEET 2: LOT 18 PROPERTY OF JACK HOWLEY JERALYN A. HOWLEY

## FREELAND & ASSOCIATES

Engineers • Land Surveyors

GREENVILLE, S.C.

SURVEY J. R.F. & D.C.N. DRAWN 8.R CHECK MC SCALE "= 30' DATE JAN. 10.83 DWG. NO. 8262