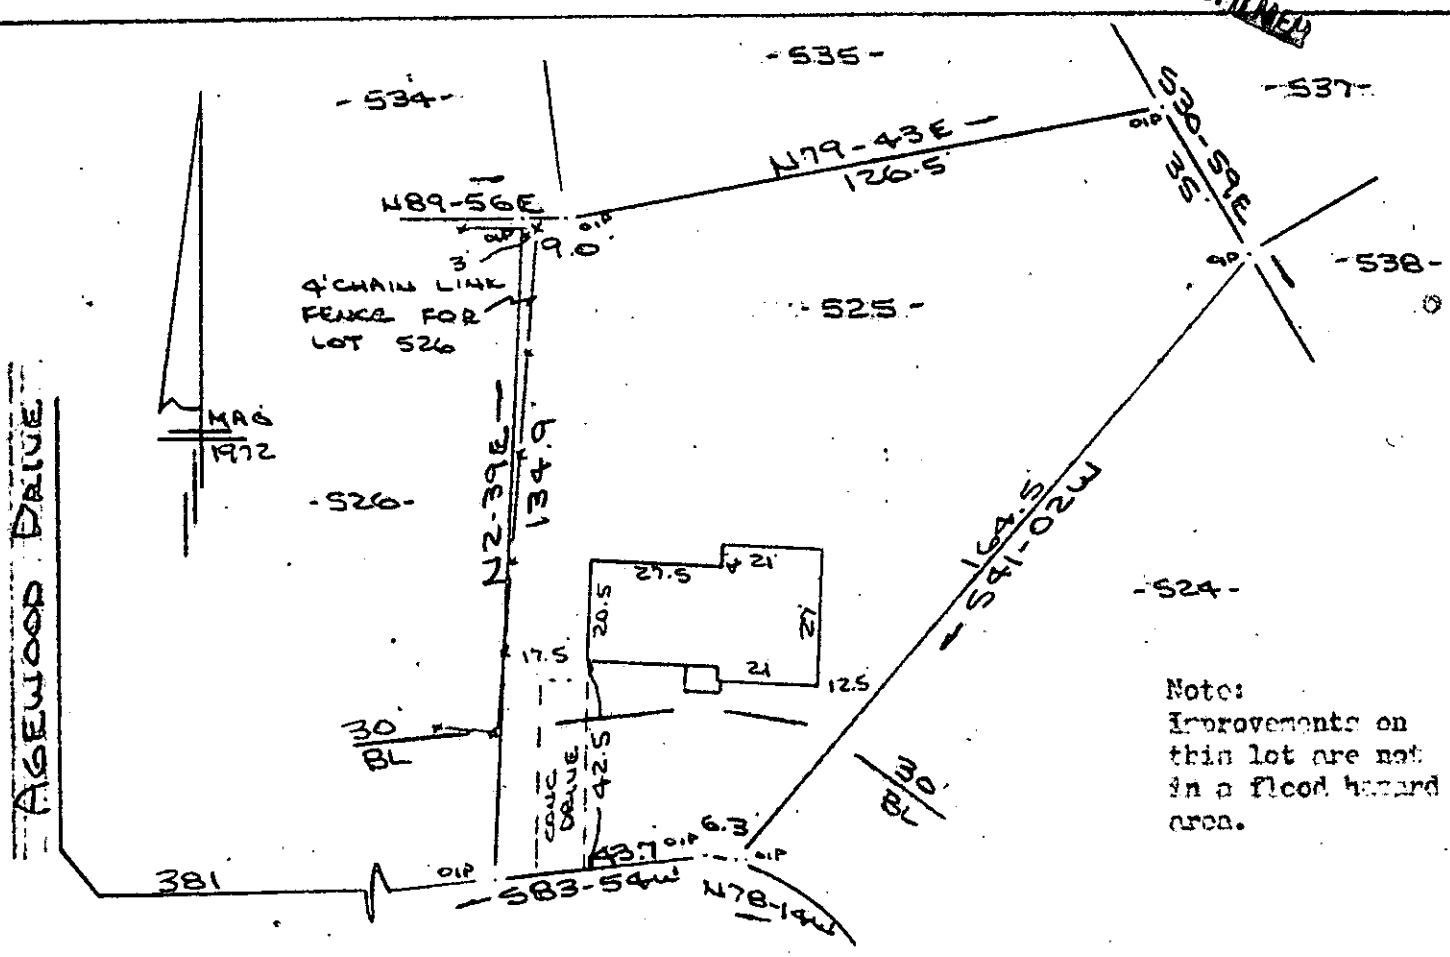

AGEWOOD COURT
WATER & SEWER IN ST R/W

PROPERTY OF
WILLIAM DAVID LINE & SANDRA ANN LINE
SIMPSONVILLE, S.C.
SCALE: 1"=40 20 JAN 1983

40 20 0 40

This is to certify that on the 20th day of January, 1983, I surveyed the property shown on this plat, being known as lot 525 on plat of SHEET NO. TWO WESTWOOD SECTION V and recorded in the RMC Office Greenville County, S. C., in Plat Book " 4 - X " at Page 63; and that the property lines, walls and buildings are as shown hereon, and that the walls and buildings located on said lot do not encroach or project on adjacent street or property, and that no adjacent walls or buildings encroach or project on said premises, and no power lines cross this property except as shown hereon.

9-L-72

18903

R. B. Bruce

R. B. Bruce, RLS #1952

CAROLINA SURVEYING CO.
112 Manly St.
Greenville, S. C.

FEB 1 1983

GCTC --- 1 FE 1 83 1304

3.00CI

FILED
GREENVILLE CO. S.C.
FEB 1 11 03 AM '83
DONNIE S. TANKERSLEY
R.M.C.

17368