
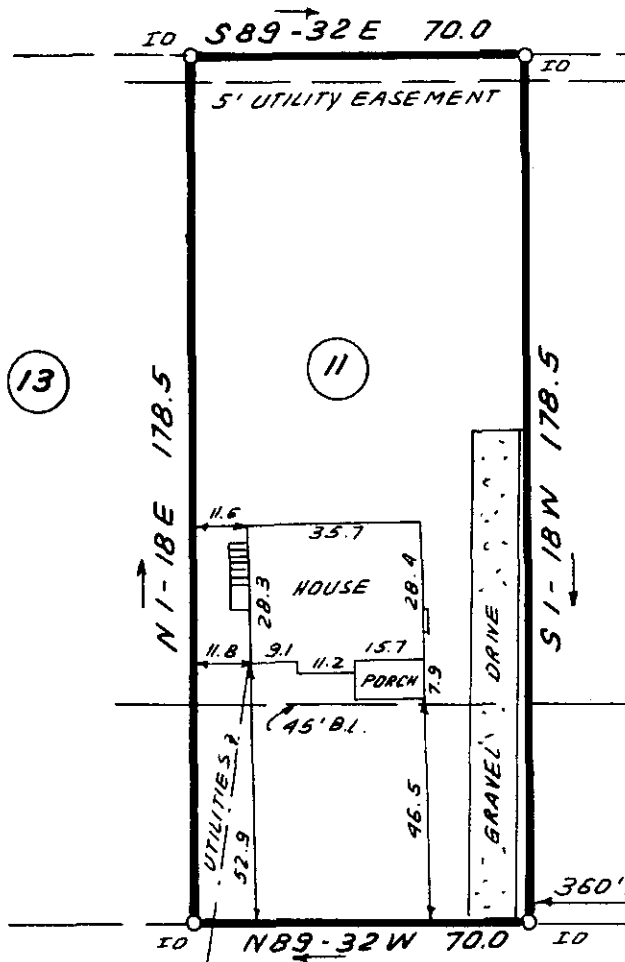


FILED  
GREENVILLE CO. S. C.  
FEB 2 9 54 AM '83  
DONNIE S. TANKERSLEY  
R.M.C.

MICROFILMED

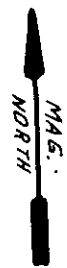

This is to certify that on January 28, 1983, I surveyed the property shown on this plat, known as Lot 11 on Plat of Northwoods Subdivision, recorded in the RMC Office of Greenville County in Plat Book P on Page 123, and that the property lines, walls and buildings are as shown hereon; that the building located on said lot does not encroach or project on adjacent streets or property, and that no adjacent walls or buildings encroach or project on said premises, and that no utility lines cross this property except as shown hereon. This property is not located in a designated flood hazard area.

*James R. Freeland*  
James R. Freeland PLS & PE 4781

**WINDSOR DRIVE**

19044

FEB 2 1983

9-L-76 ✓



300 8 17571801



**STATE OF SOUTH CAROLINA  
GREENVILLE COUNTY**

NORTHWOODS

LOT 11

PROPERTY OF  
JAMES W. GARRICK JR.  
ALICE B. GARRICK

FREELAND & ASSOCIATES  
Engineers • Land Surveyors

GREENVILLE, S.C.

SURVEY	DCH
DRAWN	B.R.
CHECK	MC
SCALE	1" = 40'
DATE	JAN. 28 83
DWG. NO.	8361