

MICROFILMED

FILED
GREENVILLE CO. S. C.

FEB 3 4 50 PM '83

DONNIE S. TANKERSLEY
R.M.C.

MICHAEL F. TALLEY

GENE A. ACKER
O.I.P. 195.6
N 77.30 E

3.7 AC.



LOCAL POWER SERVICE

LOCAL POWER SERVICE

Note: Improvements on this lot are not in a flood hazard area.

BOLING ROAD

MAG 1973

MICHAEL F. TALLEY
N 5-33 E
243.9

IRIS A. STANSELL
N 71-12 E
220.5
DIRT DRIVE 264.1 TOT


RAYMOND L. BROWN
S 29-22 W 400.3'

ROY W. FLEMING
S 69-38 W NE C. 582-59 W

19247

9-L-87

PROPERTY OF
JAMES E. ACKER
NEAR GREENVILLE, S.C.
SCALE 1" = 100 31 JAN 1983

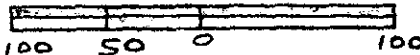

GC10 --- 1 FE 383


040

This is to certify that on the 31st day of January, 1983, I surveyed the property shown on this plat, being known as 3.7 acres on plat of PROPERTY OF JAMES E. ACKER and recorded in the RMC Office Greenville County, S. C., in Plat Book at Page and that the property lines, walls and buildings are as shown hereon, and that the walls and buildings located on said lot do not encroach or project on said premises, and no power lines cross this property except as shown hereon.

R. B. Bruce

R. B. Bruce, R.S. 1952

CAROLINA SURVEYING CO.
112 Manly St., Greenville, S. C.

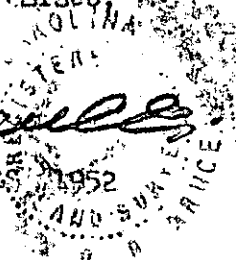

249/2

254-3-8