

This is to certify that on January 31, 1983, I surveyed the property shown on this plat, known as Property of Michael S. & Patricia T. Martin, recorded in the RMC Office of Greenville County in Deed Book 1171 on Page 324, and that the property lines, walls and buildings are as shown hereon; that the building located on said lot does not encroach or project on adjacent streets or property, and that no adjacent walls or buildings encroach or project on said premises, and that no utility lines cross this property except as shown hereon. This property is not located in a designated flood hazard area.


James R. Freeland PLS & PE 4781

FEB 1 1983

18954

9-M-3

GREENVILLE CO. S.C.
 FILED
 FEB 1 4 34 PM '83
 DONNIE S. TANKERSLEY
 R.M.C.

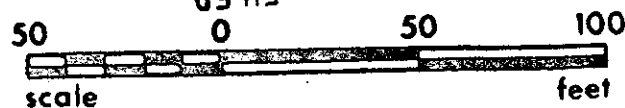

STATE OF SOUTH CAROLINA
 GREENVILLE COUNTY

PROPERTY OF
MICHAEL S. MARTIN
PATRICIA T. MARTIN

FREELAND & ASSOCIATES
 Engineers • Land Surveyors

GREENVILLE, S.C.

SURVEY	L.T.
DRAWN	B.R.
CHECK	M.C.
SCALE	1" = 50'
DATE	JAN. 31. 83
DWG. NO.	8366

MICROFILMED