


FEB 16 12 39 PM '83
DONNIE S. YANKERSLEY
R.M.C.

MICROFILMED

NOTE: Ref. NEW PROPERTY LINE, LOTS 5 & 6
SEE PLAT Bk. 7X Pg 49 TIMBER CREEK.

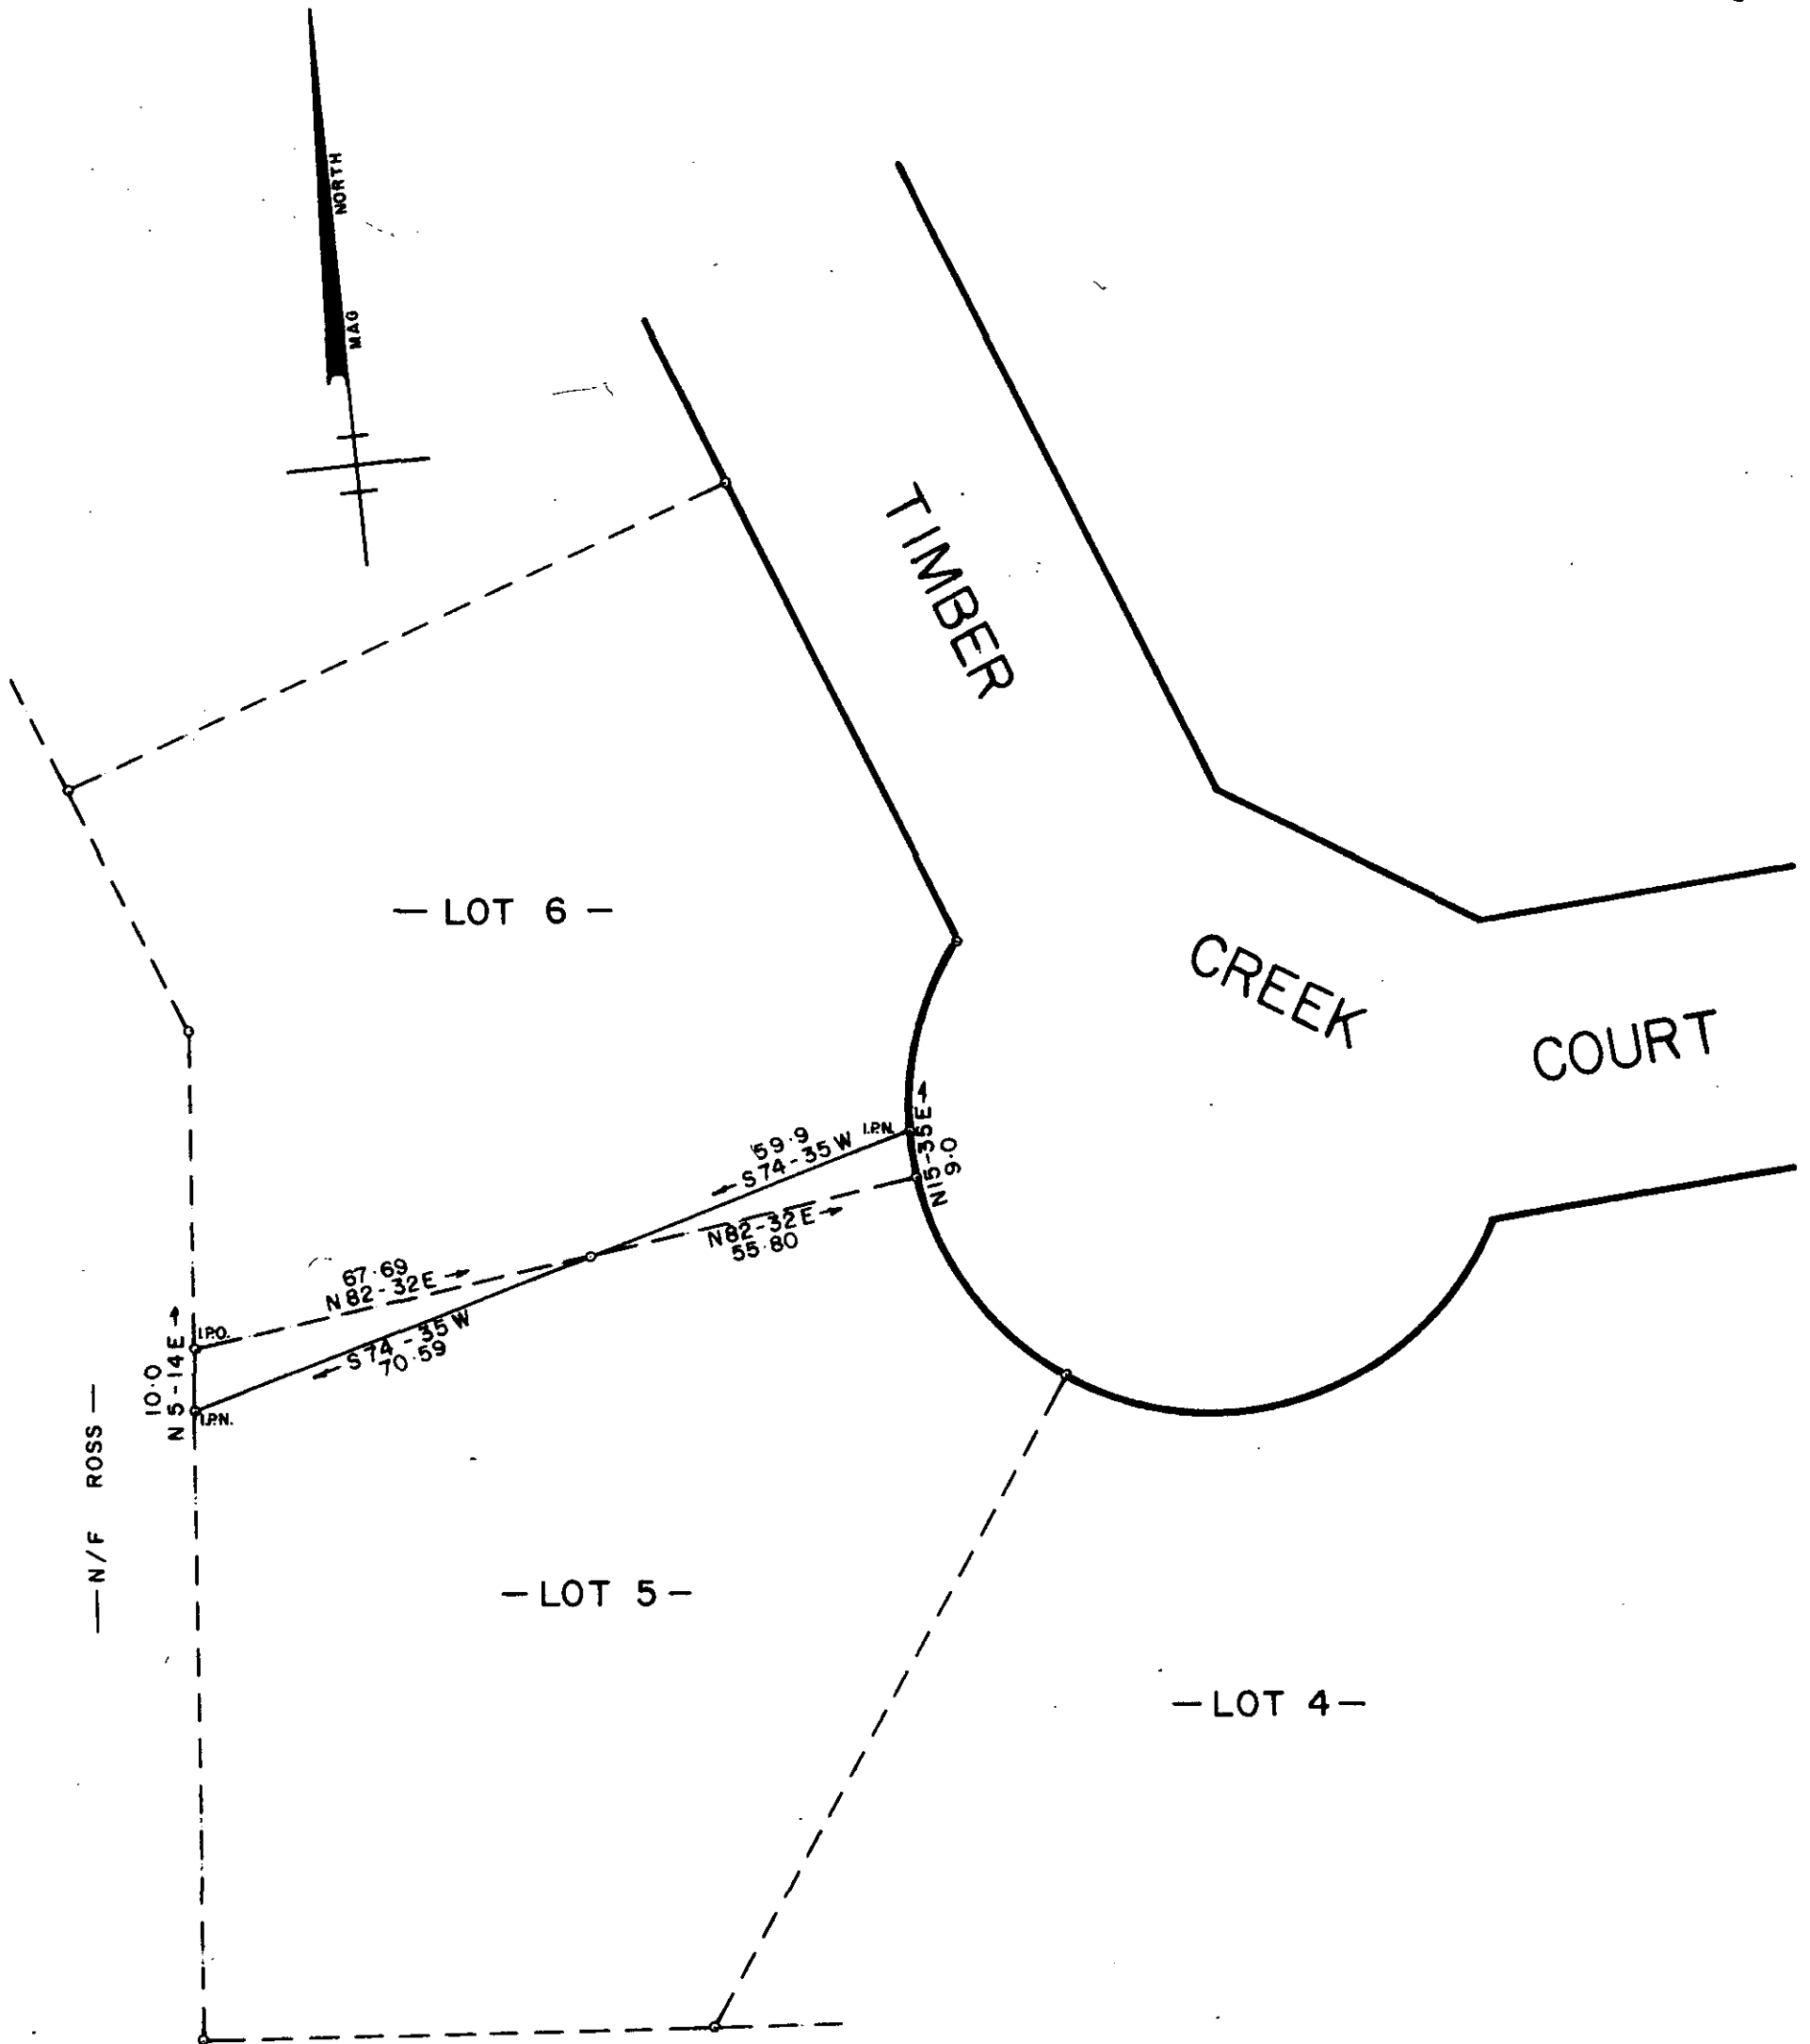

SURVEY FOR
SARAH HARMON
 NEAR GREENVILLE GREENVILLE CO.
 SOUTH CAROLINA

FEB 16 1983

JANUARY - 24 - 1983

9M-14

20350

SCALE: 1" = 30'



WRW

W. R. WILLIAMS, JR.
 ENGR. / SURVEYOR, Inc.
 P. E. & L. S. No. 3979
 15 S. MAIN STREET
 TRAVELERS REST, S. C.
 29690

T 31 - 1 - 51

"I hereby certify that the ratio of precision of the field survey is 1/5000 as shown hereon and the area was determined by D.M.D. method of area calculation."

W. R. Williams, Jr. P. E. & L. S. No. 3979