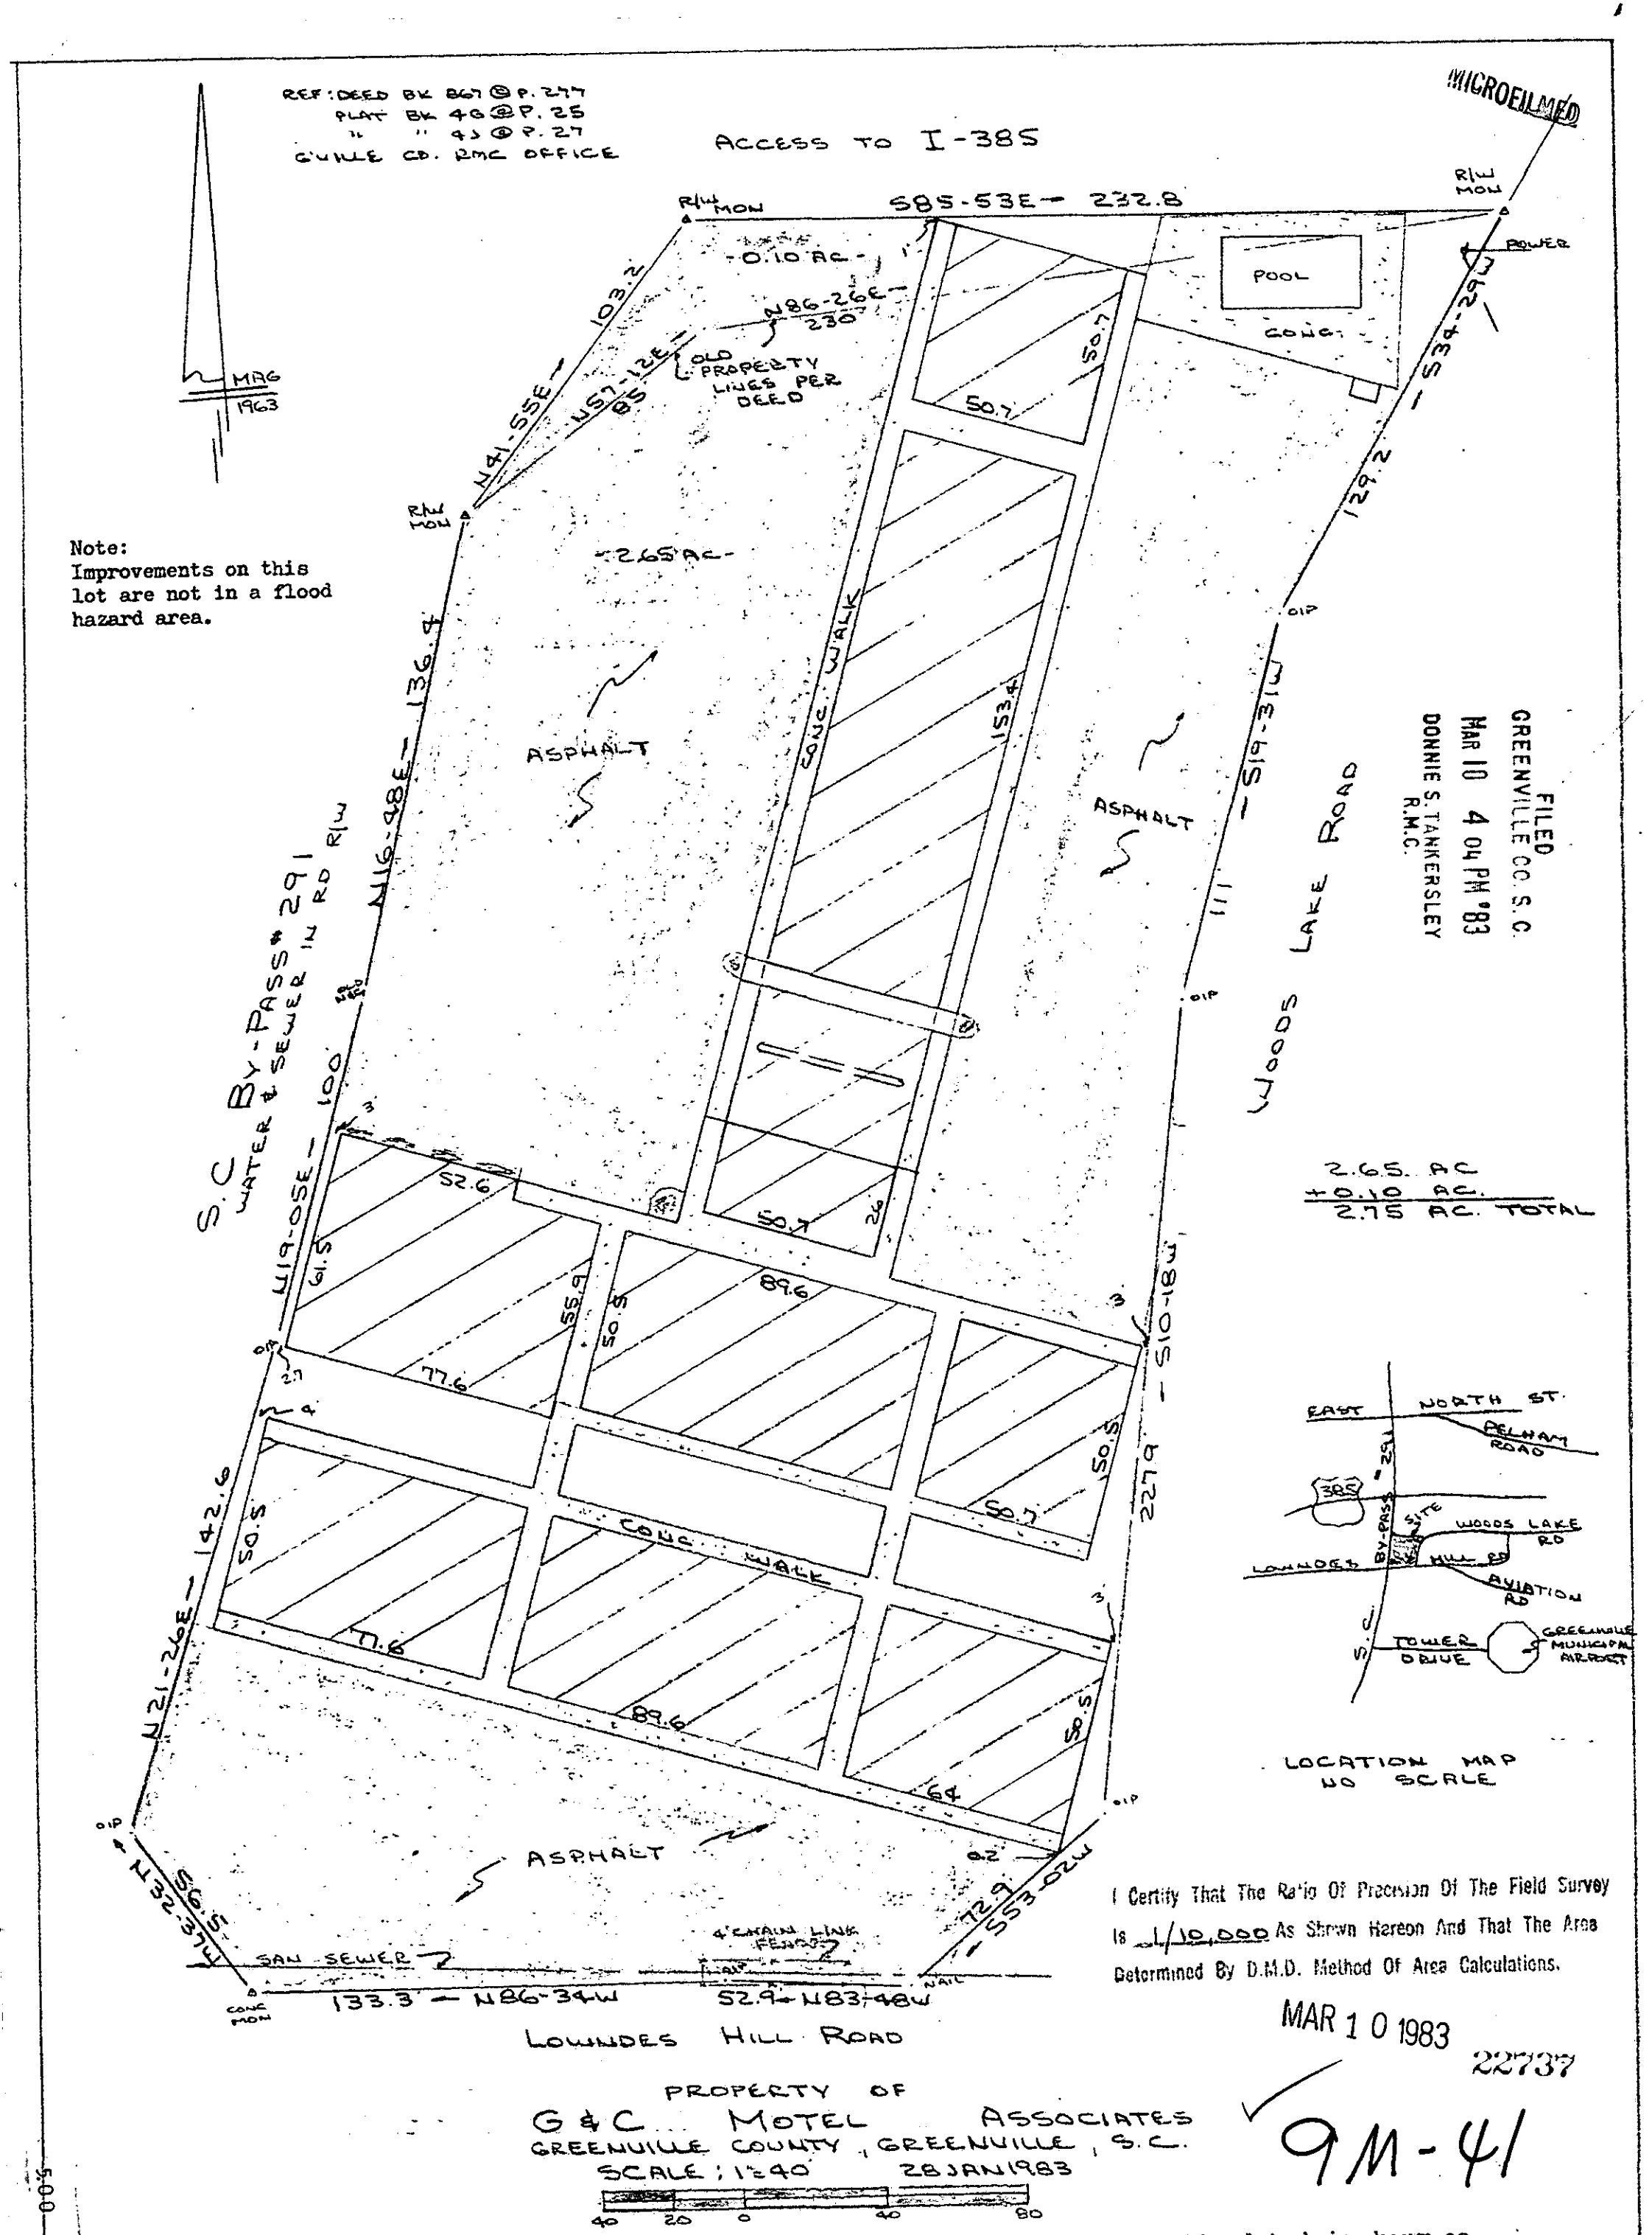


Note:
Improvements on this lot are not in a flood hazard area.

MICROFILMED

FILED
GREENVILLE CO. S.C.
MAR 10 4 04 PM '83
DONNIE S. TANKERSLEY
R.M.C.

I Certify That The Ratio Of Precision Of The Field Survey Is 1/10,000 As Shown Hereon And That The Area Determined By D.M.D. Method Of Area Calculations.

MAR 10 1983

22737

PROPERTY OF
G & C MOTEL ASSOCIATES
GREENVILLE COUNTY, GREENVILLE, S.C.
SCALE: 1"=40' 28 JAN 1983

9M-41

This is to certify that on the 28th day of January, 1983, I surveyed the property shown on this plat, being known as PROPERTY OF G & C MOTEL ASSOCIATES and recorded in the RMC Office Greenville County, S. C., in Plat Book at Page ; and that the property lines, walls and buildings are as shown hereon, and that the walls and buildings located on said lot do not encroach or project on adjacent street or property, and that no adjacent walls or buildings encroach or project on said premises, and no power lines cross this property except as shown hereon.

R. B. Bruce
R. B. Bruce, RLS #1952

CAROLINA SURVEYING CO.
112 MANLY ST.
GREENVILLE, S.C.

5.00 8 25521B01

282-1-6