



Note:

Reference Plat Book H - Page 144 A.

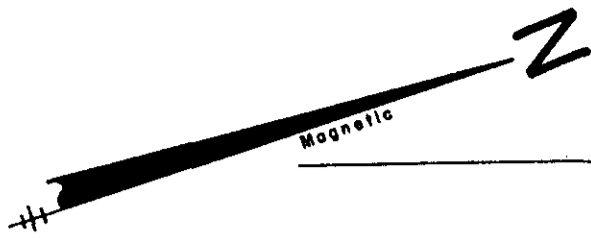

LANFORD STREET

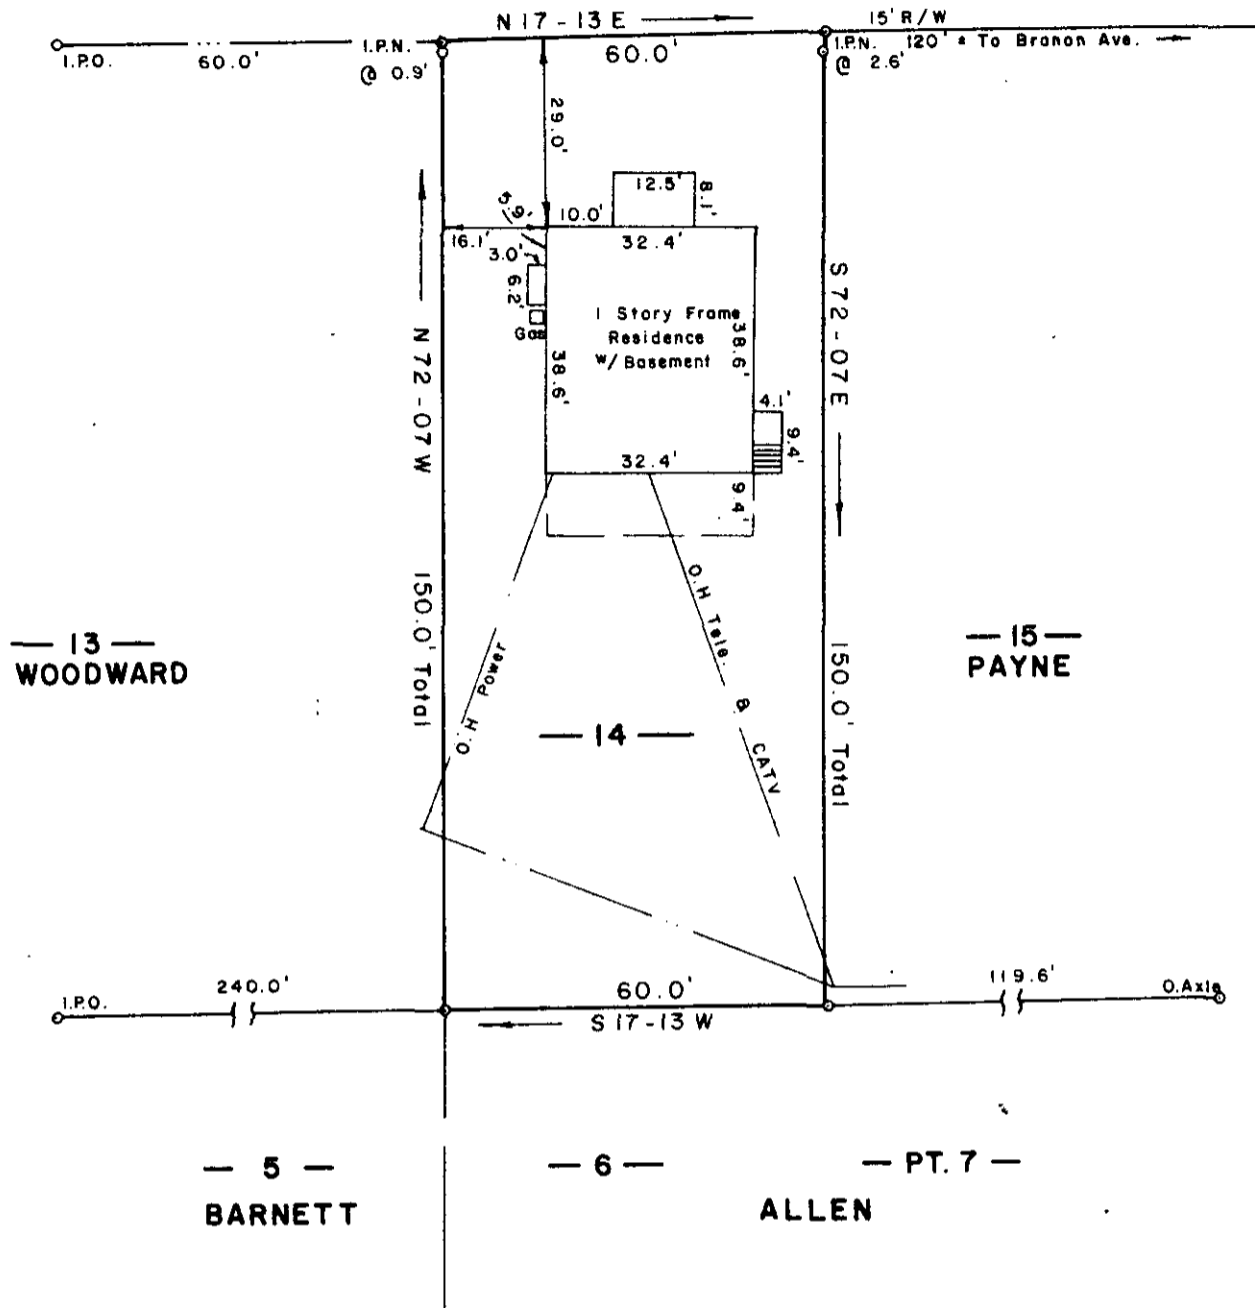

FILED
 GREENVILLE CO. S.C.
 MAR 24 1 46 PM '83
 DONNIE S. TANKERSLEY
 R.M.C.

SURVEY FOR KENNETH G. YOUNG KAREN H. YOUNG

CITY OF GREER GREENVILLE COUNTY
 SOUTH CAROLINA
 MARCH 10, 1983

MAR 24 1983

9-M-53

24178

To The Best Of My Knowledge This Structure Is Not In An Established Flood Zone.


I Hereby Certify That The Measurements As Shown Above Are Correct And There Are No Encroachments Or Projections Other Than Shown.

I Hereby Certify That The Ratio Of Precision Of The Field Survey Is 1/5000 As Shown Hereon And The Area Was Determined By D. M. D. Method.

JEFFERY M. PLUMBLEE, INC.
 LAND SURVEYING



Jeffery M. Plumblee
 R.L.S. # 7881

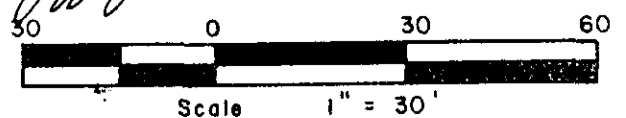

P. O. BOX 788
 TRAVELERS REST, S. C. 29690

(803) 834-4426

G 23 - 2 - 13

F. B. 11