


This is to certify that on February 8, 1982, I surveyed the property shown on this plat, known as Part of Lot 17 on the plat of University Heights, recorded in the RMC Office of Greenville County in Plat Book Y on page 53, and that the property lines, walls and buildings are as shown hereon; that the building located on said lot does not encroach or project on adjacent streets or property, and that no adjacent walls or buildings encroach or project on said premises, and that no utility lines cross this property except as shown hereon. This property is not located in a designated flood hazard area.

GREENVILLE COUNTY
 FILED
 FEB 8 3 28 PM '83
 DONNIE S. STANKERSLEY
 R.M.C.

James R. Freeland
 James R. Freeland PLS and PE 4781

FEB 8 1983

9N-3 19631

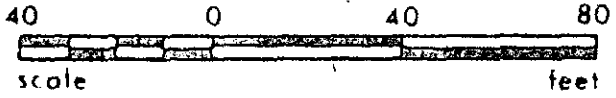

**STATE OF SOUTH CAROLINA
 GREENVILLE COUNTY**

UNIVERSITY HEIGHTS
PT. LOT 17
PROPERTY OF
JULIUS C. ENGLISH
BARBARA A. ENGLISH

FREELAND & ASSOCIATES Engineers • Land Surveyors	
GREENVILLE, S.C.	
SURVEY	L.T.
DRAWN	B.R.
CHECK	M.C.
SCALE	1" = 40'
DATE	FEB. 8 83
DWG. NO.	8392