


This is to certify that on December 28, 1982, I surveyed the property shown on this plat, known as Lot 30 on the plat of BROOKFIELD WEST, section II, recorded in the RMC Office of Greenivlle County in Plat Book 7X on page 88, and that the property lines, walls and buildings are as shown hereon; that the building located on said lot does not encroach or project on adjacent streets or property, and that no adjacent walls or buildings encroach or project on said premises, and that no utiltiy lines cross this property except as shown hereon. This property is not located in a designated flood hazard area.

5' drainage and utility easement along side lot lines and a 10' easement along rear lot lines, unless/shown otherwise .

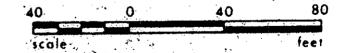



## STATE OF SOUTH CAROLINA **GREENVILLE COUNTY**

BROOKFIELD WEST 30 PROPERTY OF

ROTHELL CO. INC.

## FREELAND & ASSOCIATES Engineers • Land Surveyors

GREENVILLE, S.C.

WBH IN SURVEY DRAWN BR SCALE / /" = 40' DEC. 28.82

DWG. NO. 82/3

PRINT MACHINE INC.

Ш

 $\omega$ 

 $\infty$