



This is to certify that on February 2,1983, I surveyed the property shown on this plat, known as Lot 16 on Plat of Stratton Place, recorded in the RMC Office of Greenville County in Plat Book 4R on Page 36, and that the property lines, walls and buildings are as shown hereon; that the building located on said lot does not encroach or project on adjacent streets or property, and that no adjacent walls or buildings encroach or project on said premises, and that no utility lines cross this property except as shown hereon. This property is not located in a designated flood hazard area.

10' drainage & utility easement each side of all side & rear lot lines.

James R. Freeland PLS & PE 4781
40 0 40 80

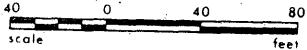

TAX BLOCK BOOK 543.10-1-16

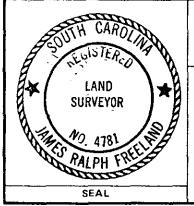

STATE OF SOUTH CAROLINA GREENVILLE COUNTY

STRATTON PLACE

LOT 16

PROPERTY OF

J. FRED BRUNSON JR.

MAZIE DANIEL BRUNSON

FREELAND & ASSOCIATES Engineers • Land Surveyors

GREENVILLE, S.C.

L	4
SURVEY Z.T.	
DRAWN B.R.	
CHECK MC	
SCALE /"= 40'	
DATE FEB. 2. 83	
DWG. NO. 8379	