


Note: Improvements on this lot are not in a flood hazard area.

FILED
GREENVILLE CO. S.C.
FEB 18 3 20 PM '83
DONNIE S. TANKERSLEY
R.M.C.

PROPERTY OF
CHARLES E. LITTLETON
GREER, GREENVILLE, CO. S.C.
SCALE 1" = 40' 15 FEB 1983

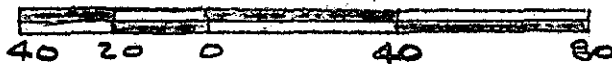

This is to certify that on the 15th day of February, 1983, I surveyed the property shown on this plat, being known as lot 9 on plat of R. H. WESTMORELAND ESTATE and recorded in the REC Office Greenville County, S. C., in Plat Book " 5 - 0 " at Page 39; and that the property lines, walls and buildings are as shown hereon, and that the walls and buildings located on said lot do not encroach or project on adjacent street or property, and that no adjacent walls or buildings encroach or project on said premises, and no power lines cross this property except as shown hereon.

9-N-36

20614

R. B. Brucy
R. B. Brucy, RLS, 1952

