MICROFILMED

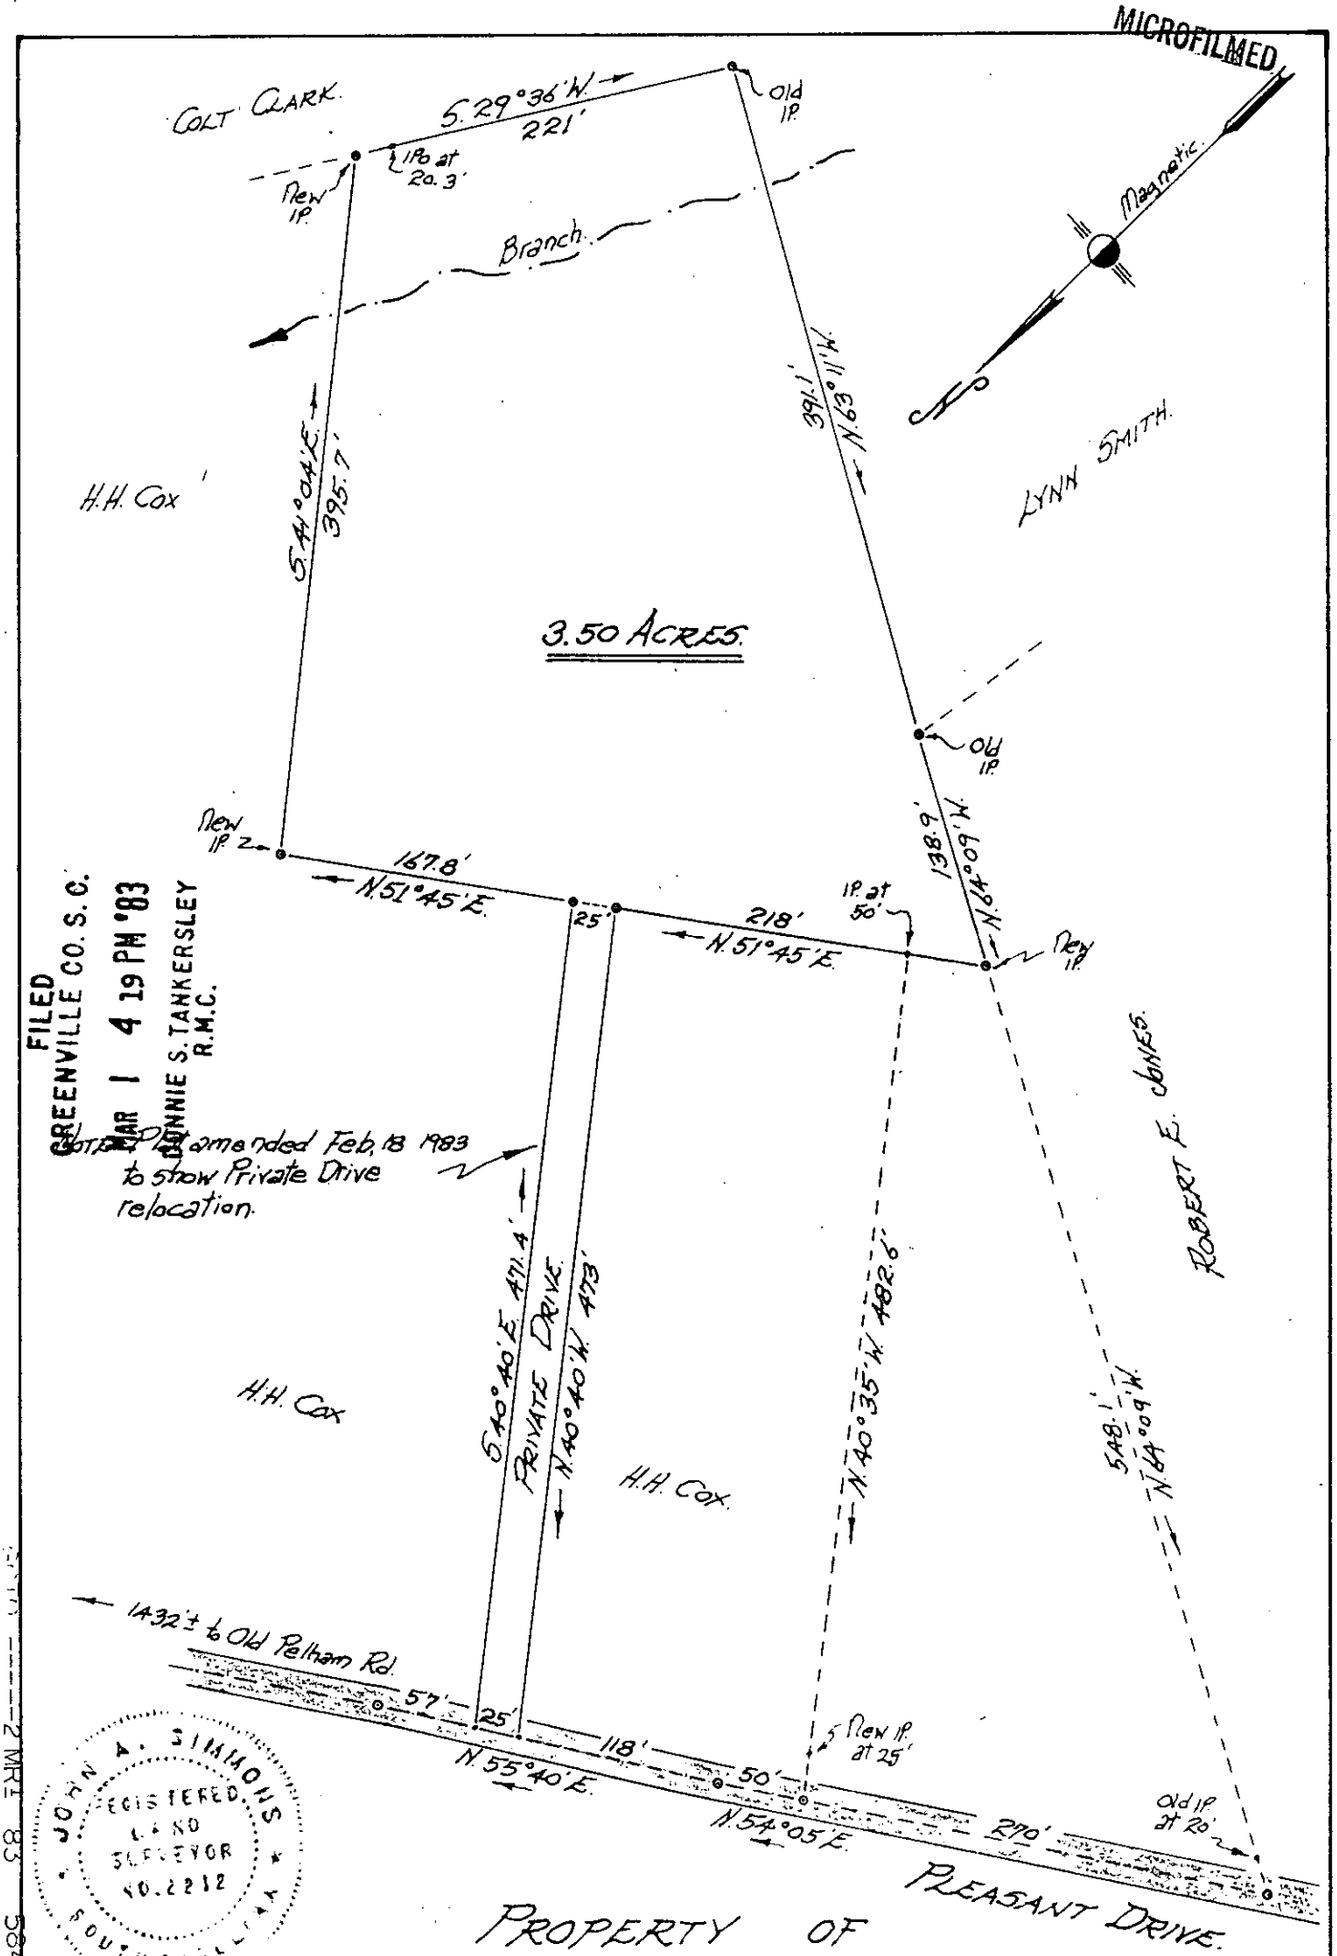

FILED
GREENVILLE CO. S. C.
MAR 1 4 19 PM '83
DONNIE S. TANKERSLEY
R.M.C.

PROPERTY OF

H.H. COX

Located near Greer.

GREENVILLE COUNTY, SOUTH CAROLINA.

SCALE: 1" = 100 FEET. APRIL 2 1976.

Tri-State Surveyors
109 Few Street
Greer, S. C. 29651

9N-79

21634

2 MRT 83 584
3.00CI