


MICROFILMED

-54-

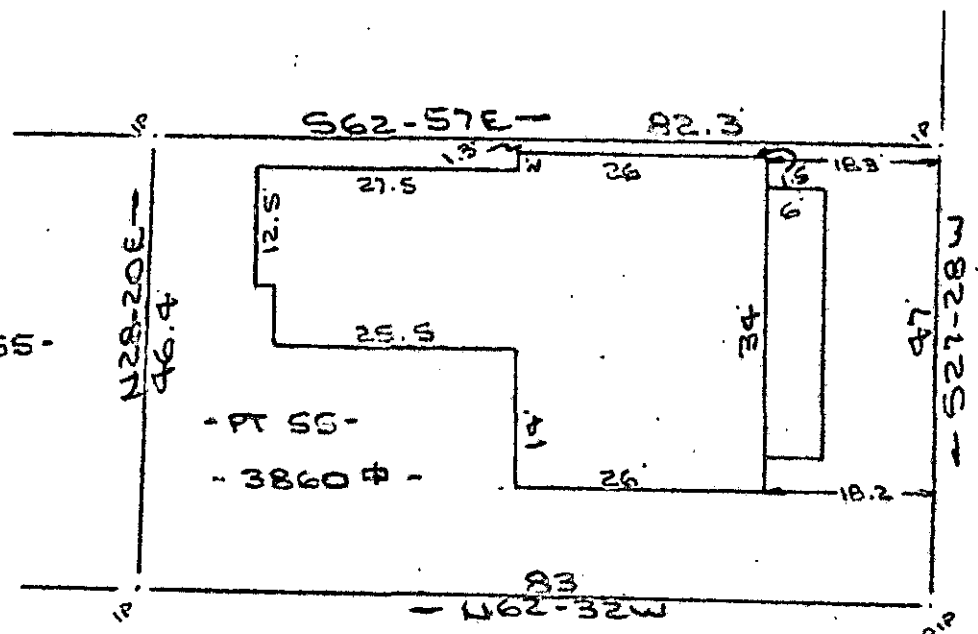


KEARNEY AVENUE
WATER & SEWER IN ST RJW

ELSIE STREET
(SALUDA AVENUE)
WATER & SEWER IN ST RJW

Note:
Improvements on this
lot are not in a
black hatched area.

PROPERTY OF
GORDON E. MASON & CHERYL A. MASON
GREENVILLE COUNTY, GREENVILLE, S.C.
SCALE: 1" = 20' 17 FEB 1983.

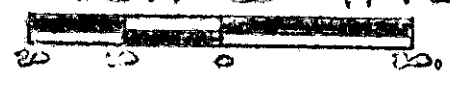

premises, and no power lines cross this property as shown hereon.

FILED
GREENVILLE CO. S. C.
MAR 3 2 48 PM '83
DONNIE S. TANKERSLEY
R.M.C.

21920

✓ 9N-88

R. B. [Signature]
R. B. [Name]

