

This is to certify that on March 5, 1983, I surveyed the property shown on this plat, known as Lot 1 on plat of property of W.R. & Essie L. Lewis, recorded in the RMC Office of Greenville County in Plat Book FF on page 410, and that the property lines, walls and buildings are as shown hereon; that the building located on said lot does not encroach or project on adjacent streets or property, and that no adjacent walls or buildings encroach or project on said premises, and that no utility lines cross this property except as shown hereon. This property is not located in a designated flood hazard area.

James R. Freeland
 James R. Freeland RLS & PE 4781

YOWN ROAD

MAR 11 1983

1838.5' ± TO
EASLEY BRIDGE RD.


22855

9-0-20



FILED
 GREENVILLE CO. S.C.
 MAR 11 1 20 PM '83
 DONNIE S. STANKERSLEY
 R.M.C.

240.2-1-14

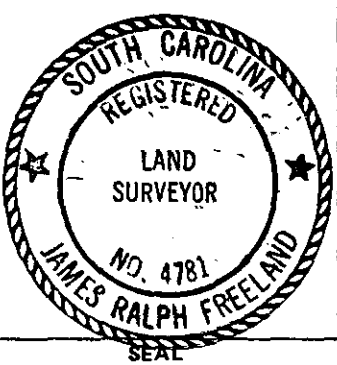

**STATE OF SOUTH CAROLINA
 GREENVILLE COUNTY**

W.R. & ESSIE L. LEWIS PROPERTY

LOT - 1
 PROPERTY OF
JAMES D. GIRARDEAU
BILLIE K. GIRARDEAU

FREELAND & ASSOCIATES
 Engineers • Land Surveyors

GREENVILLE, S.C.

SURVEY JC
 DRAWN KS
 CHECK WBA
 SCALE 1" = 30'
 DATE MARCH 5, 83
 DWG. NO. 8543

COTO 3 MR 11 83 059
 PRINTING INC.