


PROPERTY OF
SAMUEL LEROY & KAREN BROWN BEASON

Located in Greer
 GREENVILLE COUNTY, SOUTH CAROLINA.
 SCALE: 1" = 40'-0" MARCH 30 1983

This is to certify that on March 30, 1983, I surveyed the property shown on this plat, and the same is correct, and that the property lines, walls and building shown thereon, do not encroach or project on adjacent streets or property, and that no adjacent buildings or walls encroach or project on above shown property.
 This property is not located in a Flood Plane.

John A. Simmons
 Registered Surveyor in S.C.

MAR 31 1983

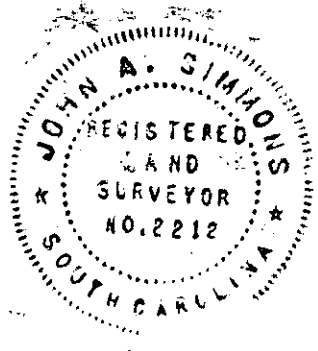

9-0-86

25052

Tri-State Surveyors
 109 Few Street
 Greer, S. C. 29651

FILED
 GREENVILLE CO. S.C.
 MAR 31 10 59 AM '83
 DONNIE S. TANKERSLEY
 R.M.C.

5310 --2 MR31 93 534 3.00CI