MICROFILMED

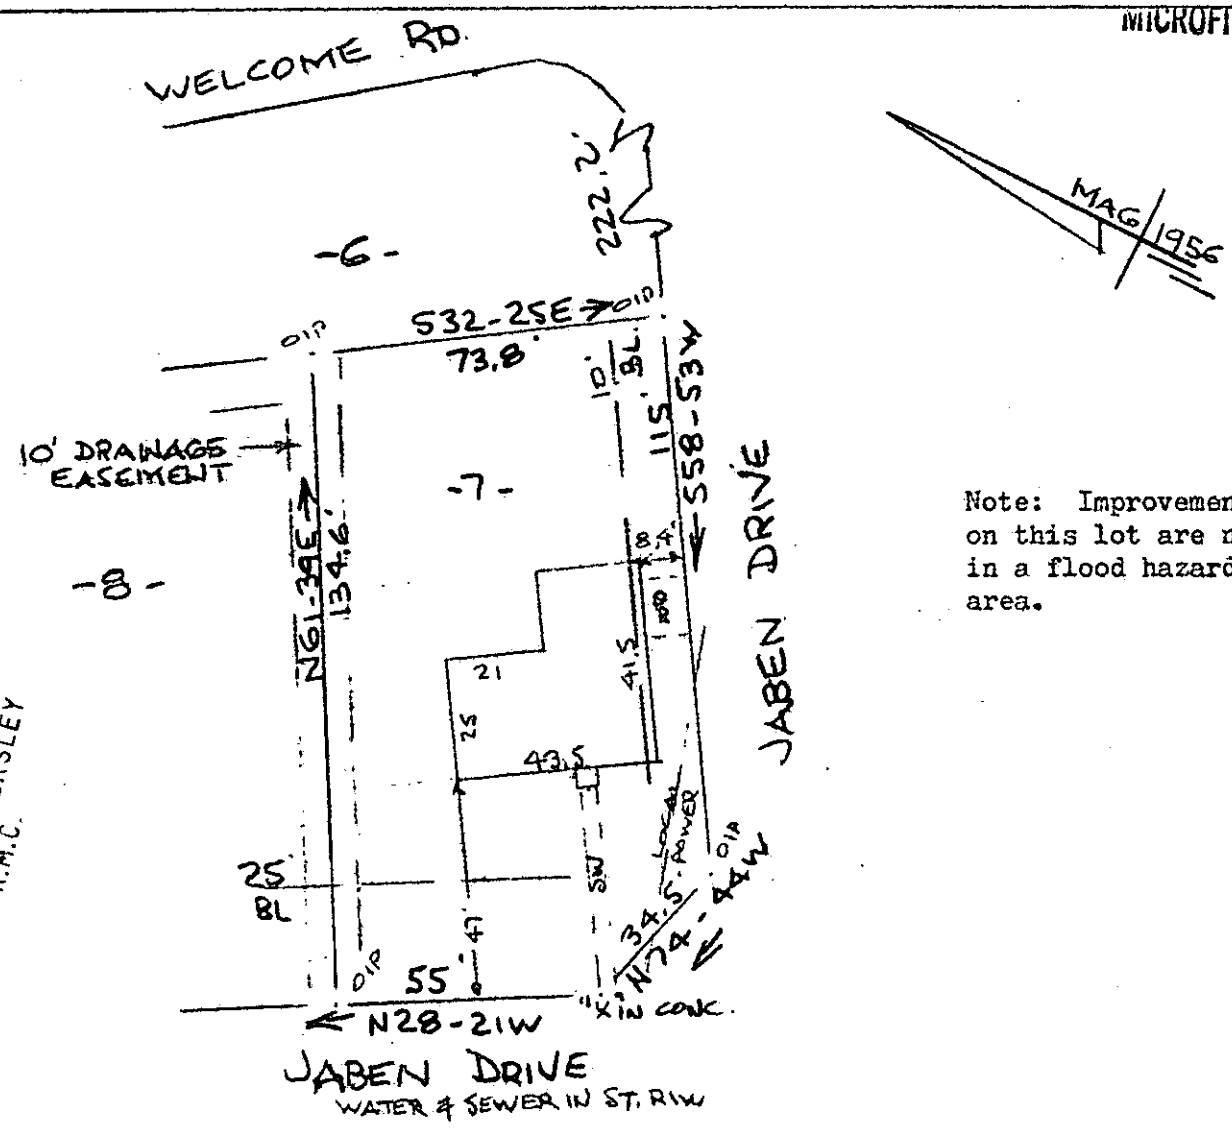


Note: Improvements on this lot are not in a flood hazard area.

FILED
GREENVILLE CO. S. C.
APR 12 1 15 PM '83
DONNIE S. TANKERSLEY
R.M.C.

PROPERTY OF
DANIEL L. BOEHM & CHARLOTTE R. BOEHM
NEAR GREENVILLE, S.C.
6 APR 1983

This is to certify that on the 6th day of April, 1983, I surveyed the property shown on this plat, being known as lot 7 on plat of PLAT NO. 2 B. P. CRENSHAW and recorded in the RMC Office Greenville County, S. C., in Plat Book " LL " at Page 142; and that the property lines, walls and buildings are as shown hereon, and that the walls and buildings located on said lot do not encroach or project on adjacent street or property, and that no adjacent walls or buildings encroach or project on said premises, and no power lines cross this property except as shown hereon.

300 8 32421B01

APR 12 1983

26439

9-P-40

R. B. Bruce, RLS #1952

CAROLINA SURVEYING CO.
112 Manly St., Greenville, S. C.