


This is to certify that on April 7, 1983, I surveyed the property shown on this plat, known as Lot 25 and Part of Lot 24 and Part 26, on the plat of D.W. Cochran Estate, recorded in the RMC Office of Greenville County in Plat Book I on page 92 and 93, and that the property lines, walls and buildings are as shown hereon; the the building located on said lot does not encroach or project on adjacent streets or property, and that no adjacent walls or buildings encroach or project on said premises, and that no utility lines cross this property except as shown hereon. This property is not located in a designated flood hazard area.

APR 14 1983

James R. Freeland
James R. Freeland PE and RLS 4781

9-P-52 ✓
26728

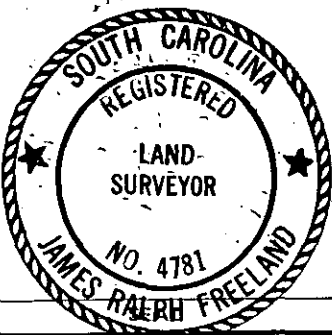

**STATE OF SOUTH CAROLINA
GREENVILLE COUNTY**

D.W. COCHRAN ESTATE
LOT 25, PART LOT 24 & 26
PROPERTY OF
PAUL BULLARD WINSTON
MARCIA HURST WINSTON

FREELAND & ASSOCIATES
Engineers • Land Surveyors

GREENVILLE, S.C.

SURVEY D.G.
DRAWN KEG
CHECK MC
SCALE 1"=40'
DATE APRIL 7, 1983
DWG. NO. 8713