
DONNIE S. TANKERSLEY MONTCLAIRE SUBDIVISION R.M.C.



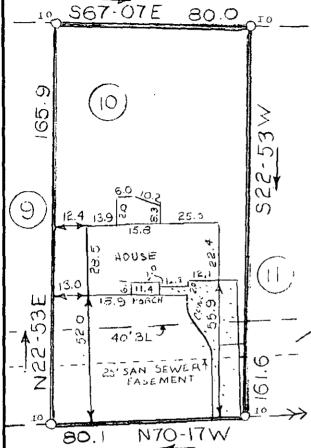


This is to certify that on March 31, 1983, I surveyed the property, shown on this plat, known as Lot 10 on the plat of Forest Trail, recorded in the RMC Office of Greenville County in Plat Book 7X on page 59, and that the property lines, walls and buildings are as shown hereon; that the building located on said lot does not encroach or project on adjacent streets or property, and that no adjacent walls or buildings encroach or project on said premises, and that no utility lines cross this property except as shown hereon. This property is not located in a designated flood hazard area.

James R. Freeland PE and RLS 4781

512.4 TO HILL RD.

BETHEL ROAD

MOTE: There is a 5' drainage & utility easement each side of all side and rear lot lines.

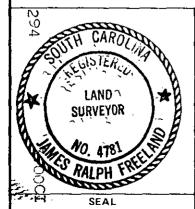

AP25

83

## STATE OF SOUTH CAROLINA **GREENVILLE COUNTY**

FOREST TRAIL PROPERTY OF DON A. MSALLISTER ANNETTE M. MEALLISTER FREELAND & ASSOCIATES Engineers • Land Surveyors

GREENVILLE, S.C.

·	
SURVEY JC	
DRAWN LG	 
CHECK MC	
SCALE  "= 40'	
DATE 3 30 83	
DWG. NO. 8683	