
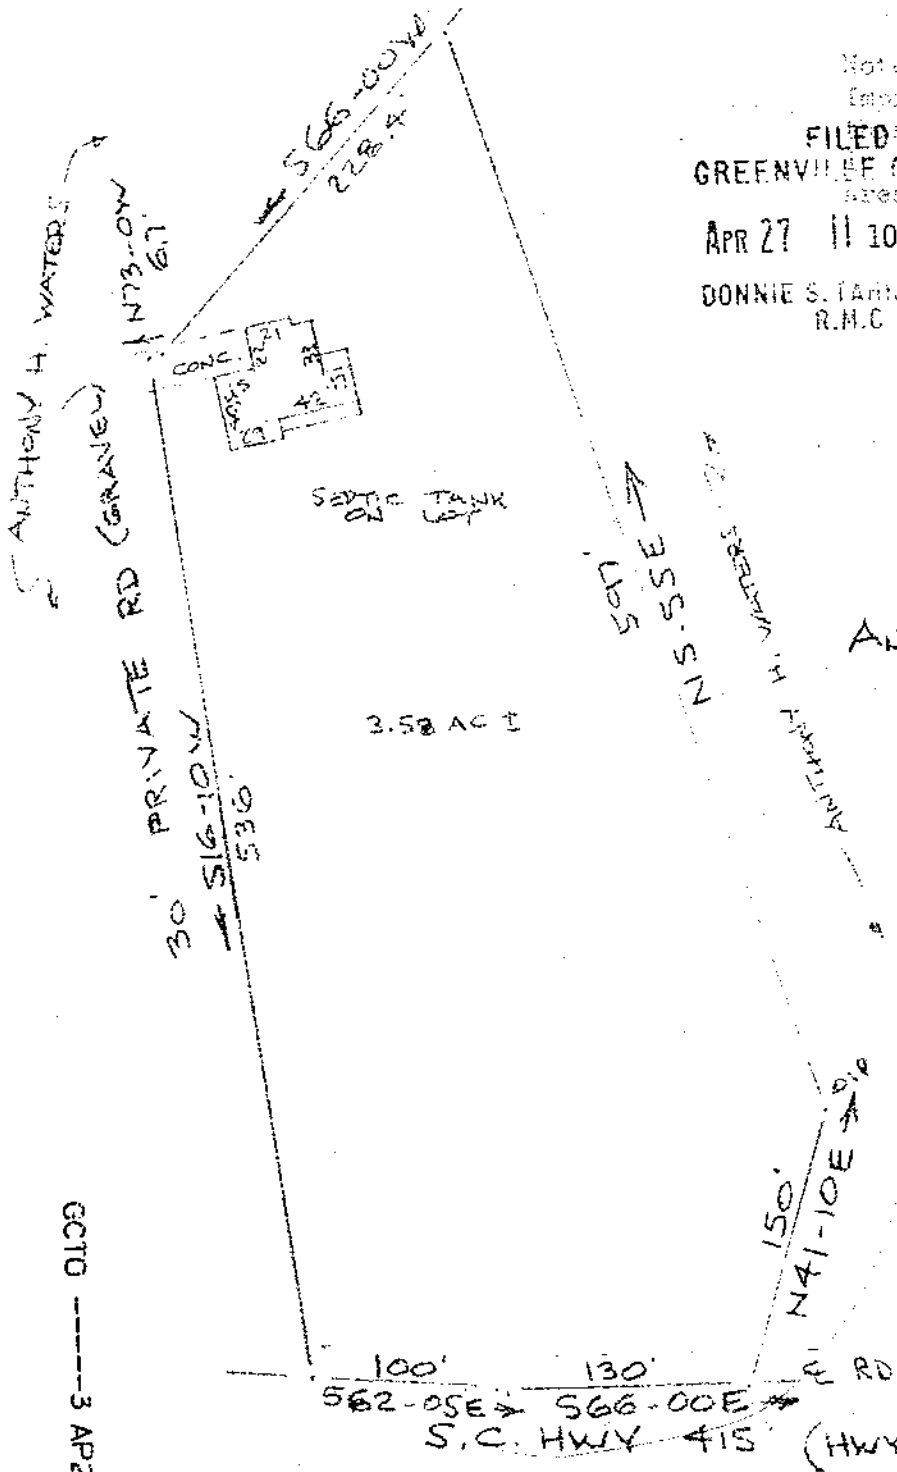


MICROFILMED

Note: Improvements on FILED Lot are not GREENVILLE 0078100 Record Area.
APR 27 11 10 AM '83
DONNIE S. TARRERSLEY R.M.C.

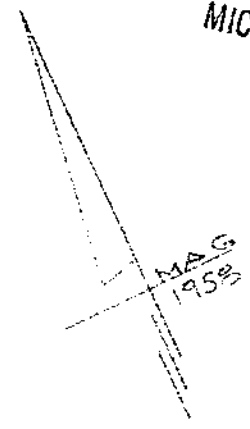

PROPERTY OF ANTHONY H. WATERS

NEAR GREENVILLE, S.C.
100 22 APR 1983 100

Note: The subject property was cut from the 51.36 acre tract (G.P. 1-1-18) owned by Anthony H. Waters and closely approximated the "3.58 acres" described in "Deed Book 522 Page 480, however we do not certify this plat to be an accurate recovery of such original 3.58 acre tract.

APR 27 1983

9-P 94
28177

GCTO ----- 3 AP 27 83 074 3.00CD

This is to certify that on the 22nd day of April, 1983, I surveyed the property shown on this plat, being known as 3.58 acres on plat of A. H. WATERS ESTATE and also known as PROPERTY OF ANTHONY H. WATERS and recorded in the REC Office Greenville County, S. C., in Plat Book at Page ; and that the property lines, walls and buildings are as shown hereon, and that the walls and buildings located on said lot do not encroach or project on adjacent street or property, and that no adjacent walls or buildings encroach or project on said premises, and no power lines cross this property except as shown hereon.

CAROLINA SURVEYING CO.
112 Main St.
Greenville, S.C.

