
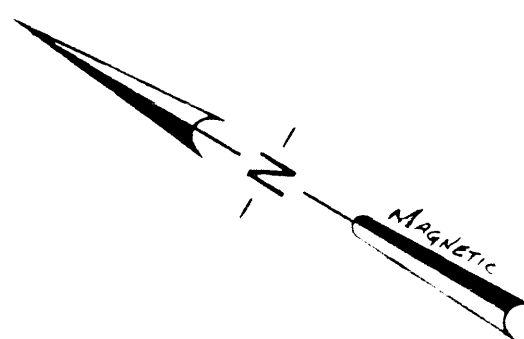



NOTES:

MICROFILMED

FILED
GREENVILLE, S.C.
JUN 23 10 44 AM '83
DONNIE S. TAYLOR
R.H.C.

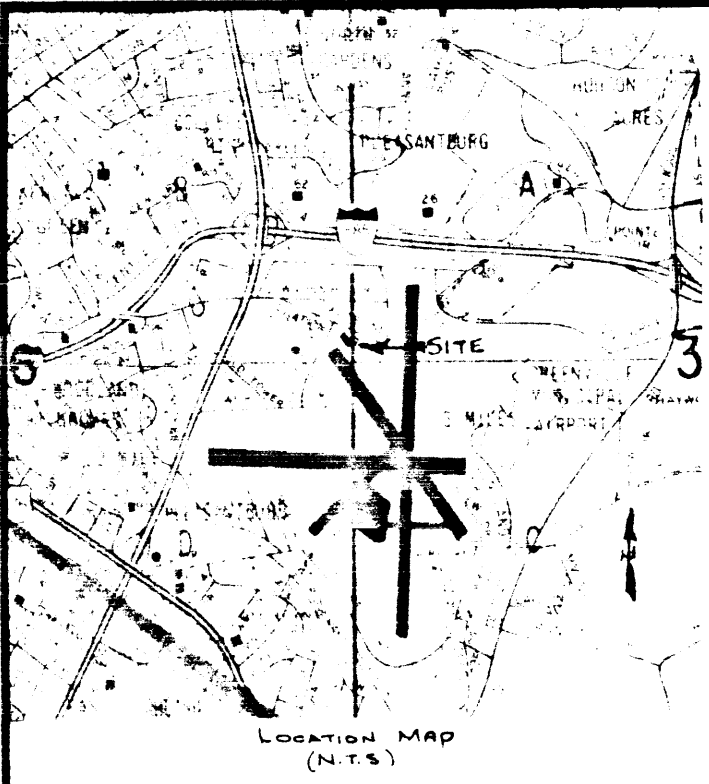

GREENVILLE AIRPORT COMM.
282-2-4

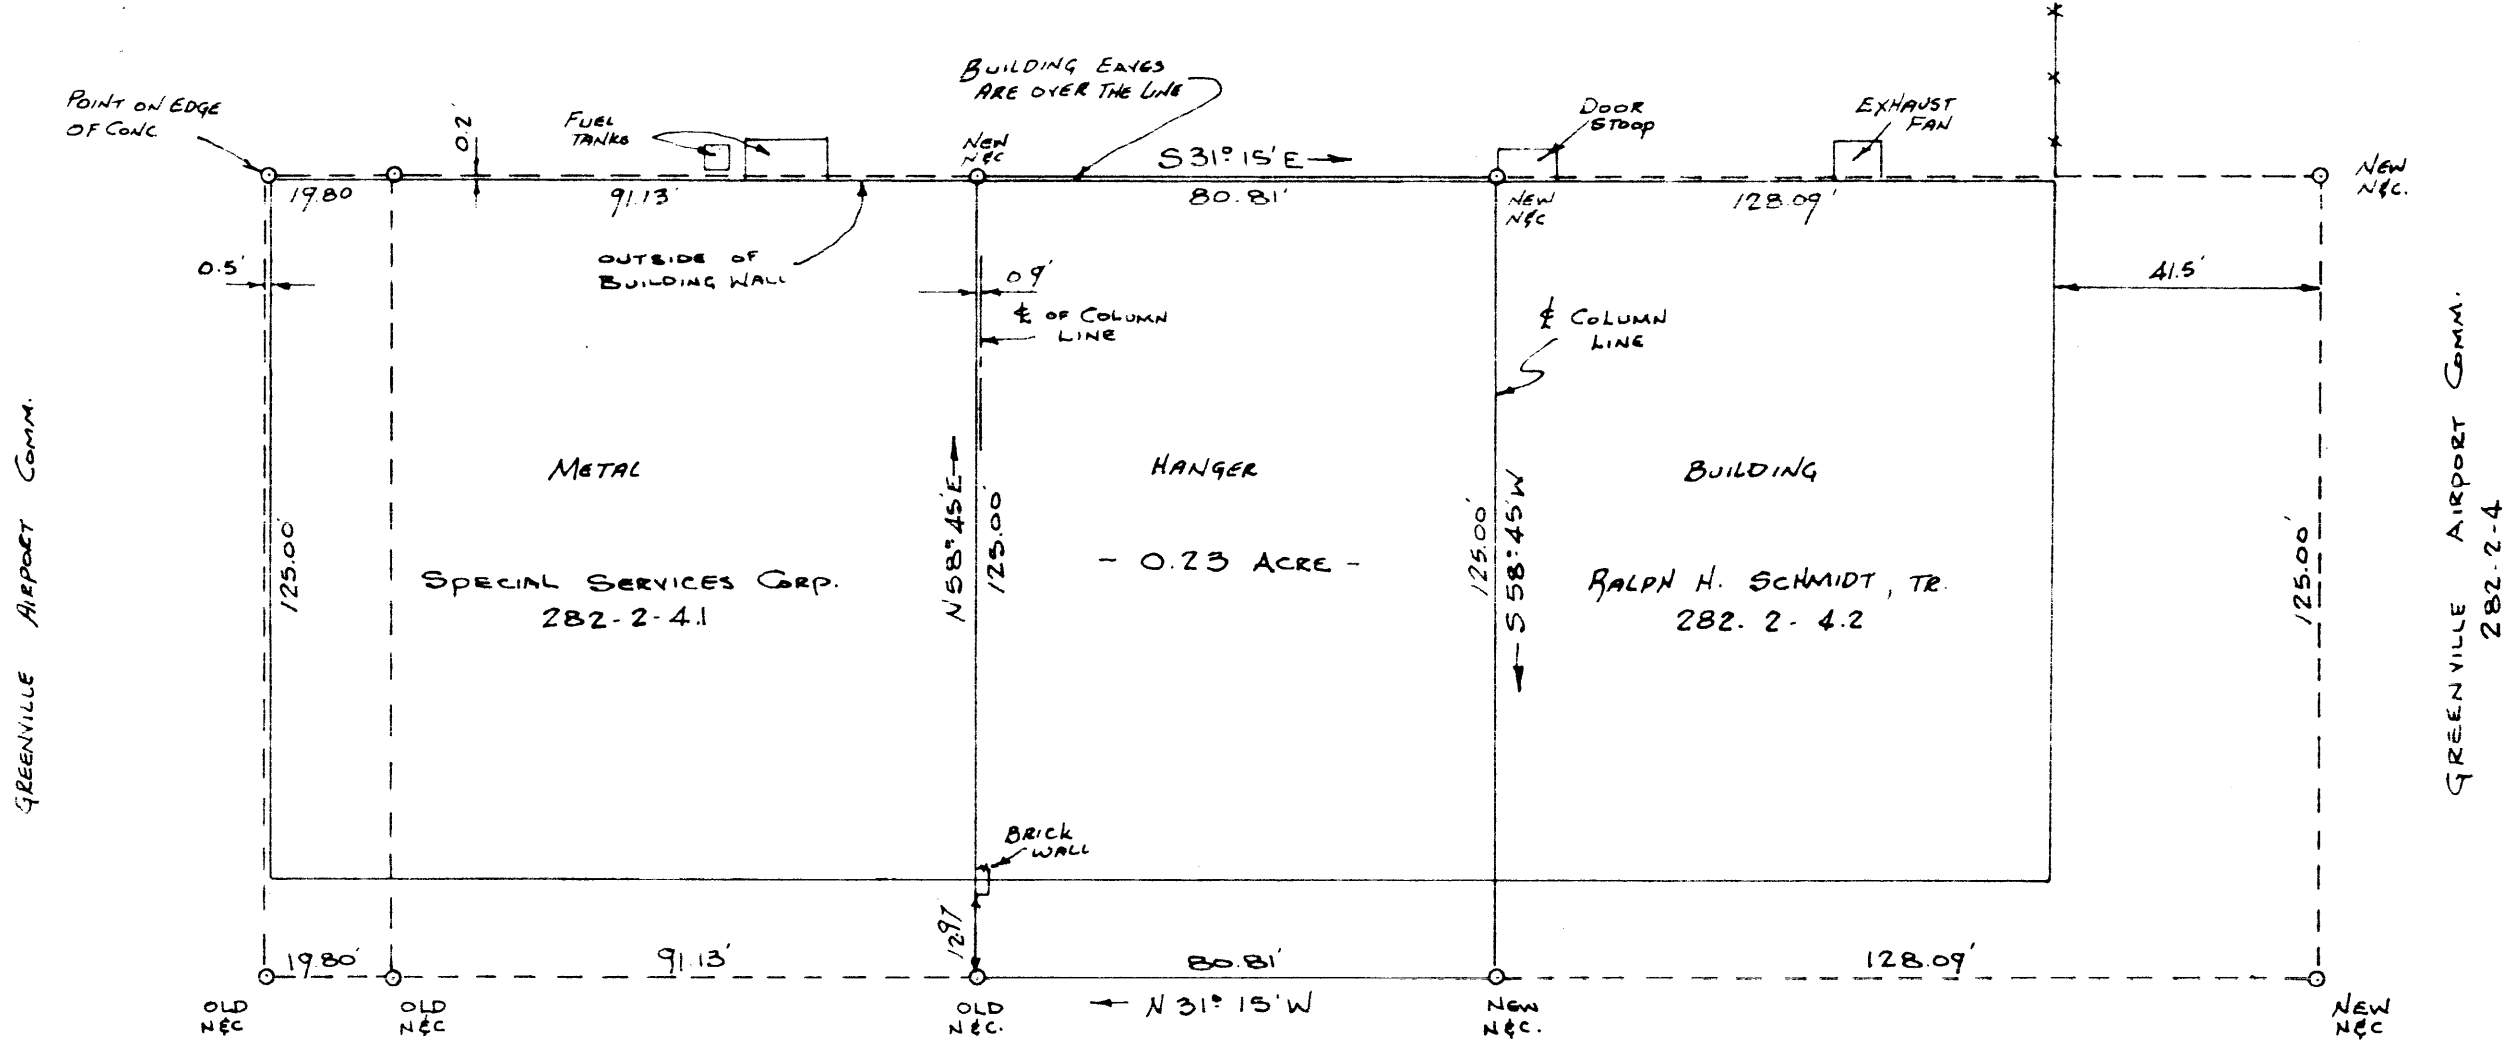

GREENVILLE AIRPORT COMM.
282-2-4


✓ 9-2-41

JUN 23 1983

34991

I HEREBY CERTIFY THAT TO THE BEST OF MY PROFESSIONAL KNOWLEDGE THE RATIO OF PRECISION OF THE FIELD SURVEY IS 1/10,000 AS SHOWN HEREON, AND THE AREA WAS DETERMINED BY D.M.D. METHOD OF AREA CALCULATION.

[Signature]
SURVEYOR'S SIGNATURE S.C. REG. NO.

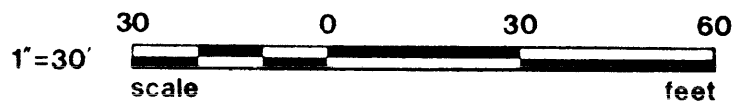

REV.	DATE	BY	DESCRIPTION	APP.
○	6/13/83	T.M.A.	FOR ISSUE	
REVISION				



SURVEY FOR:
TYLER AVIATION, INC.
 HANGER
 GREENVILLE DOWNTOWN AIRPORT
 GREENVILLE, CITY OF SOUTH CAROLINA

enwright associates, inc.
 engineers planners surveyors
 GREENVILLE, SOUTH CAROLINA

T.M.A. DRAWN	T.M.A. DESIGN	G.W.O. CHECK	FILE	RETIRED
6/13/83	1"=30'	83330-50-1-00		
DATE	SCALE	DWG NO.		

5.000CI JUN23 83 149