


FILED
 GREENVILLE CO S.C.
 AUG 3 9 51 AM '83
 DONNIE S. TANNERSLEY
 R.M.C.

MUTUAL HOME STORE OF GREER INC.

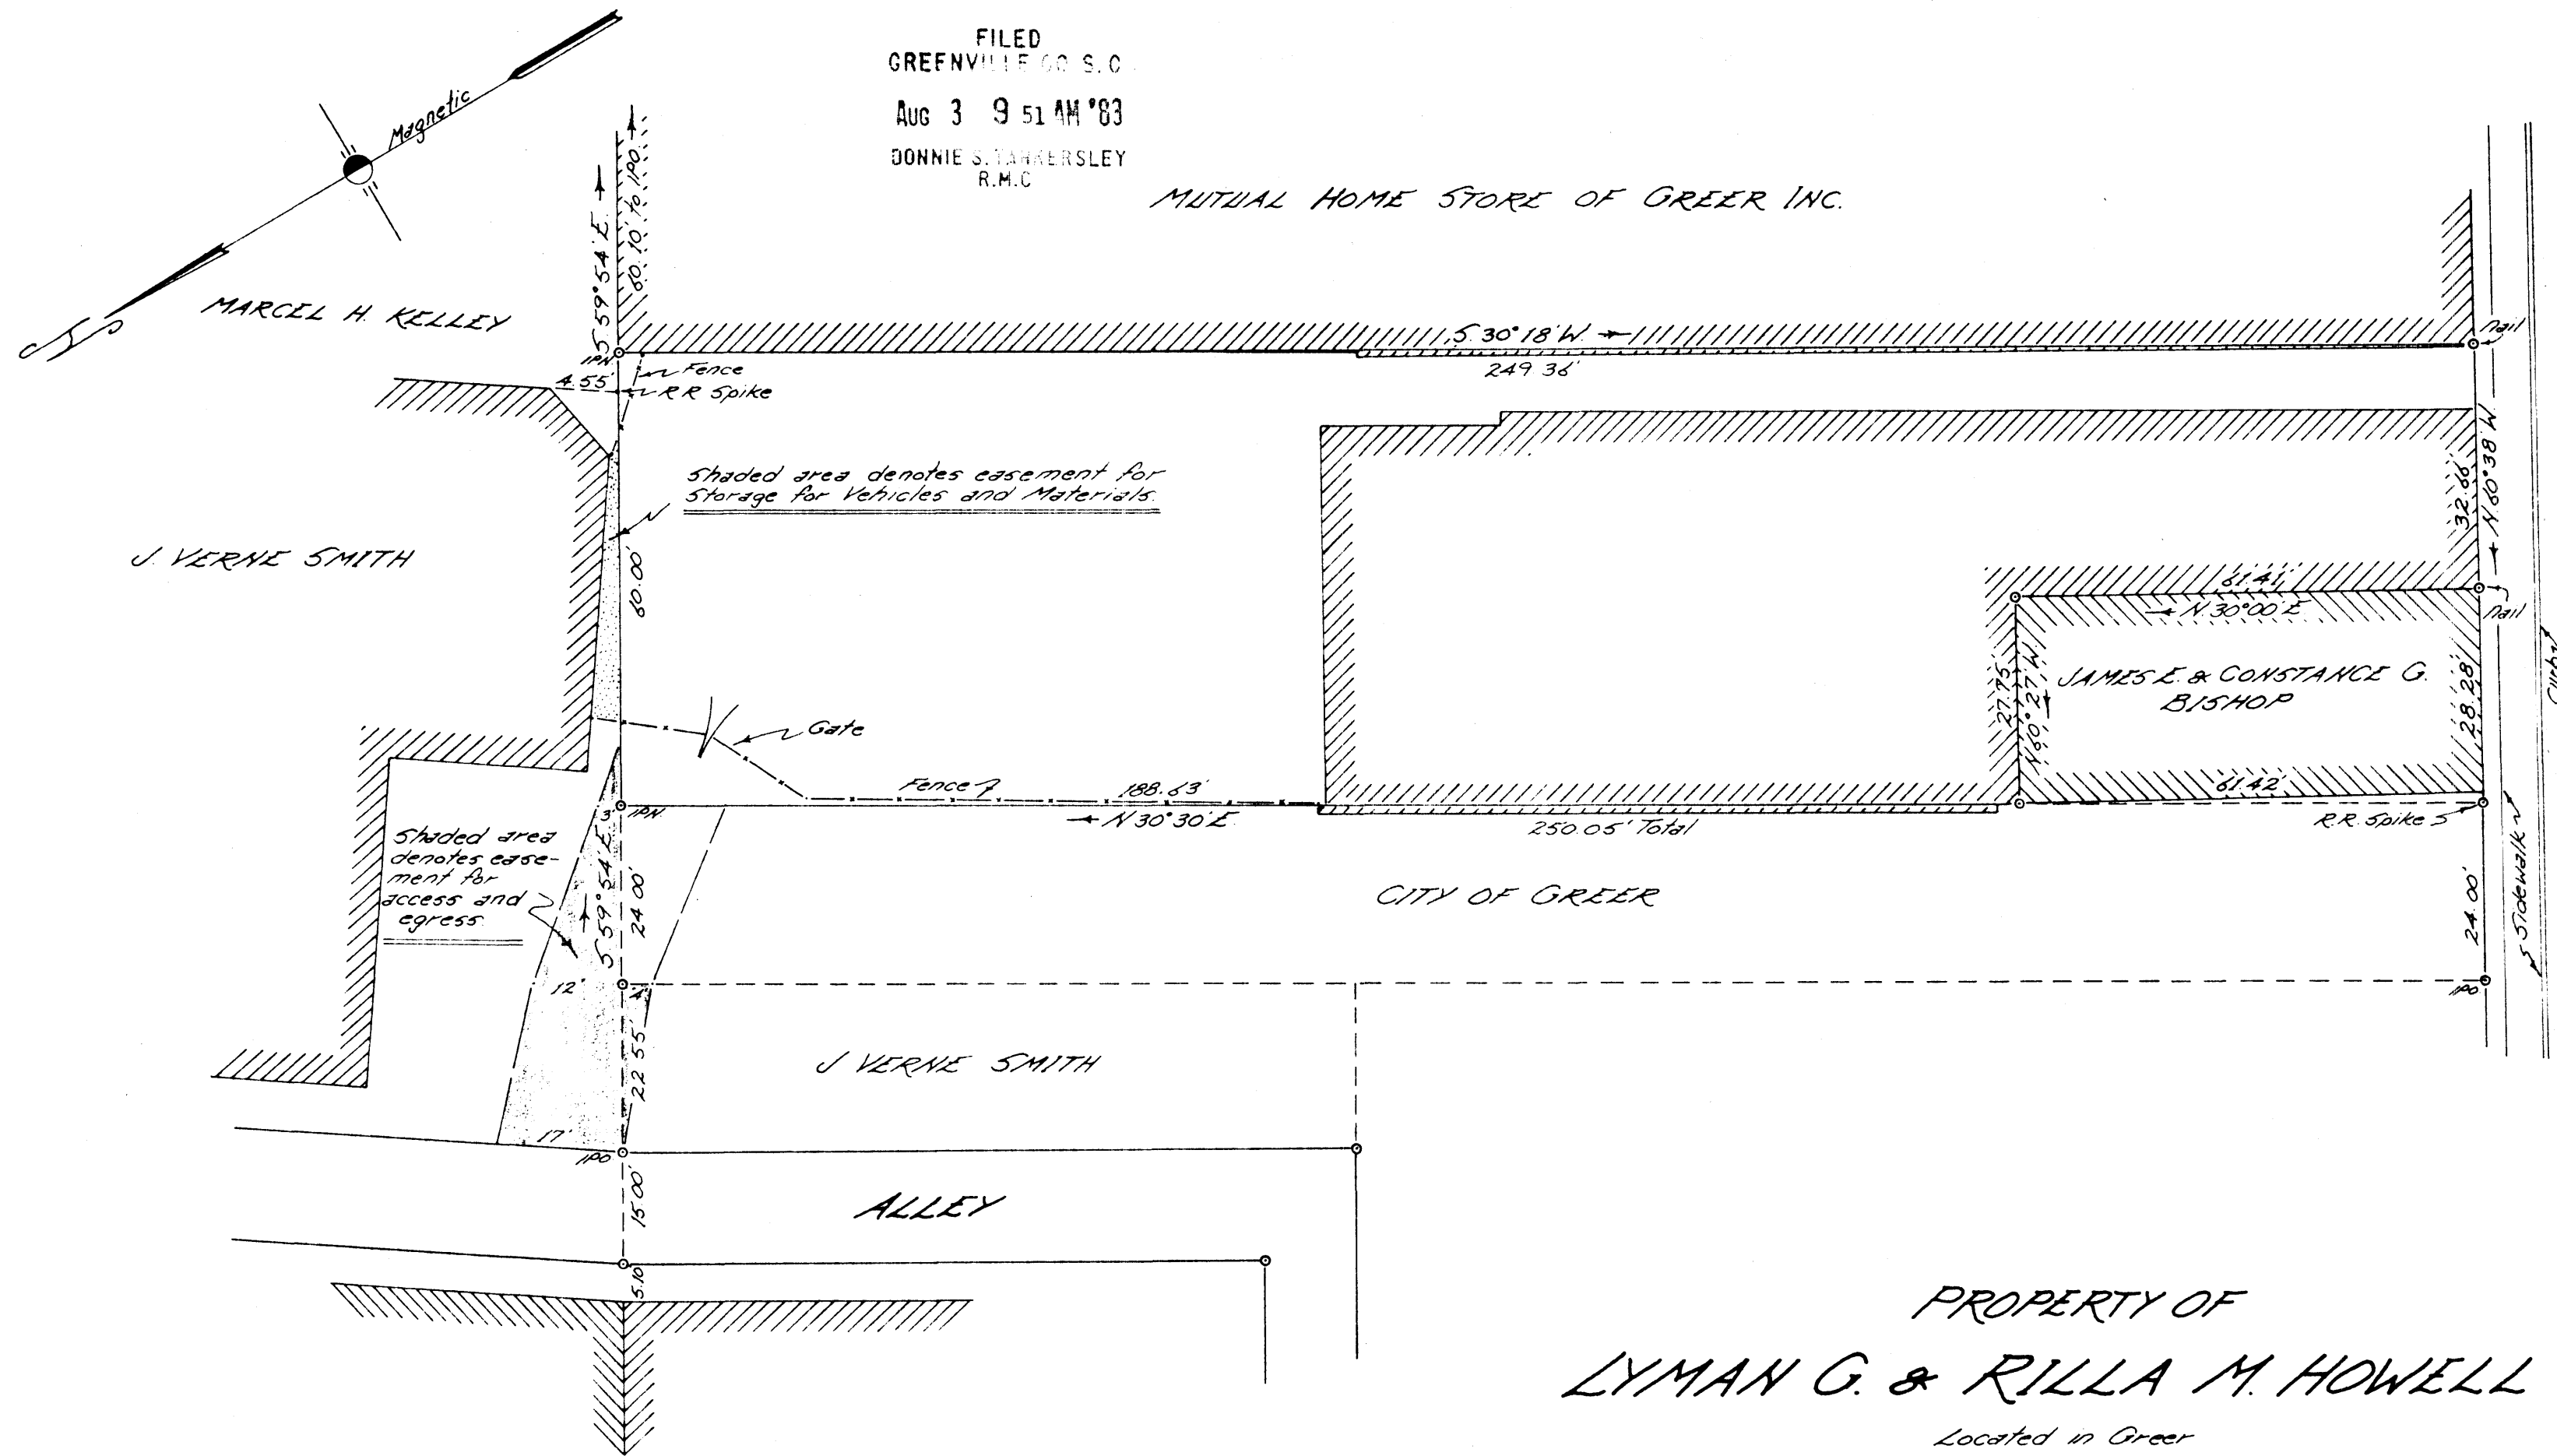


EAST POINSETT STREET

PROPERTY OF
 LYMAN G. & RILLA M. HOWELL

Located in Greer
 GREENVILLE COUNTY, SOUTH CAROLINA

SCALE: 1" = 20 FEET MARCH 18, 1983

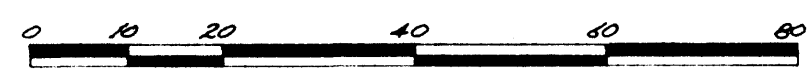

Tax Map G 21-1-14

9-9-66

4043 ✓

AUG 3 1983



I hereby certify that the ratio of precision of the field survey is 1/10,000 as shown hereon

John A. Simmons
 Reg Surveyor #2212

Tri-State Surveyors
 109 Few Street
 Greer, S. C. 29651

AEROFILMED