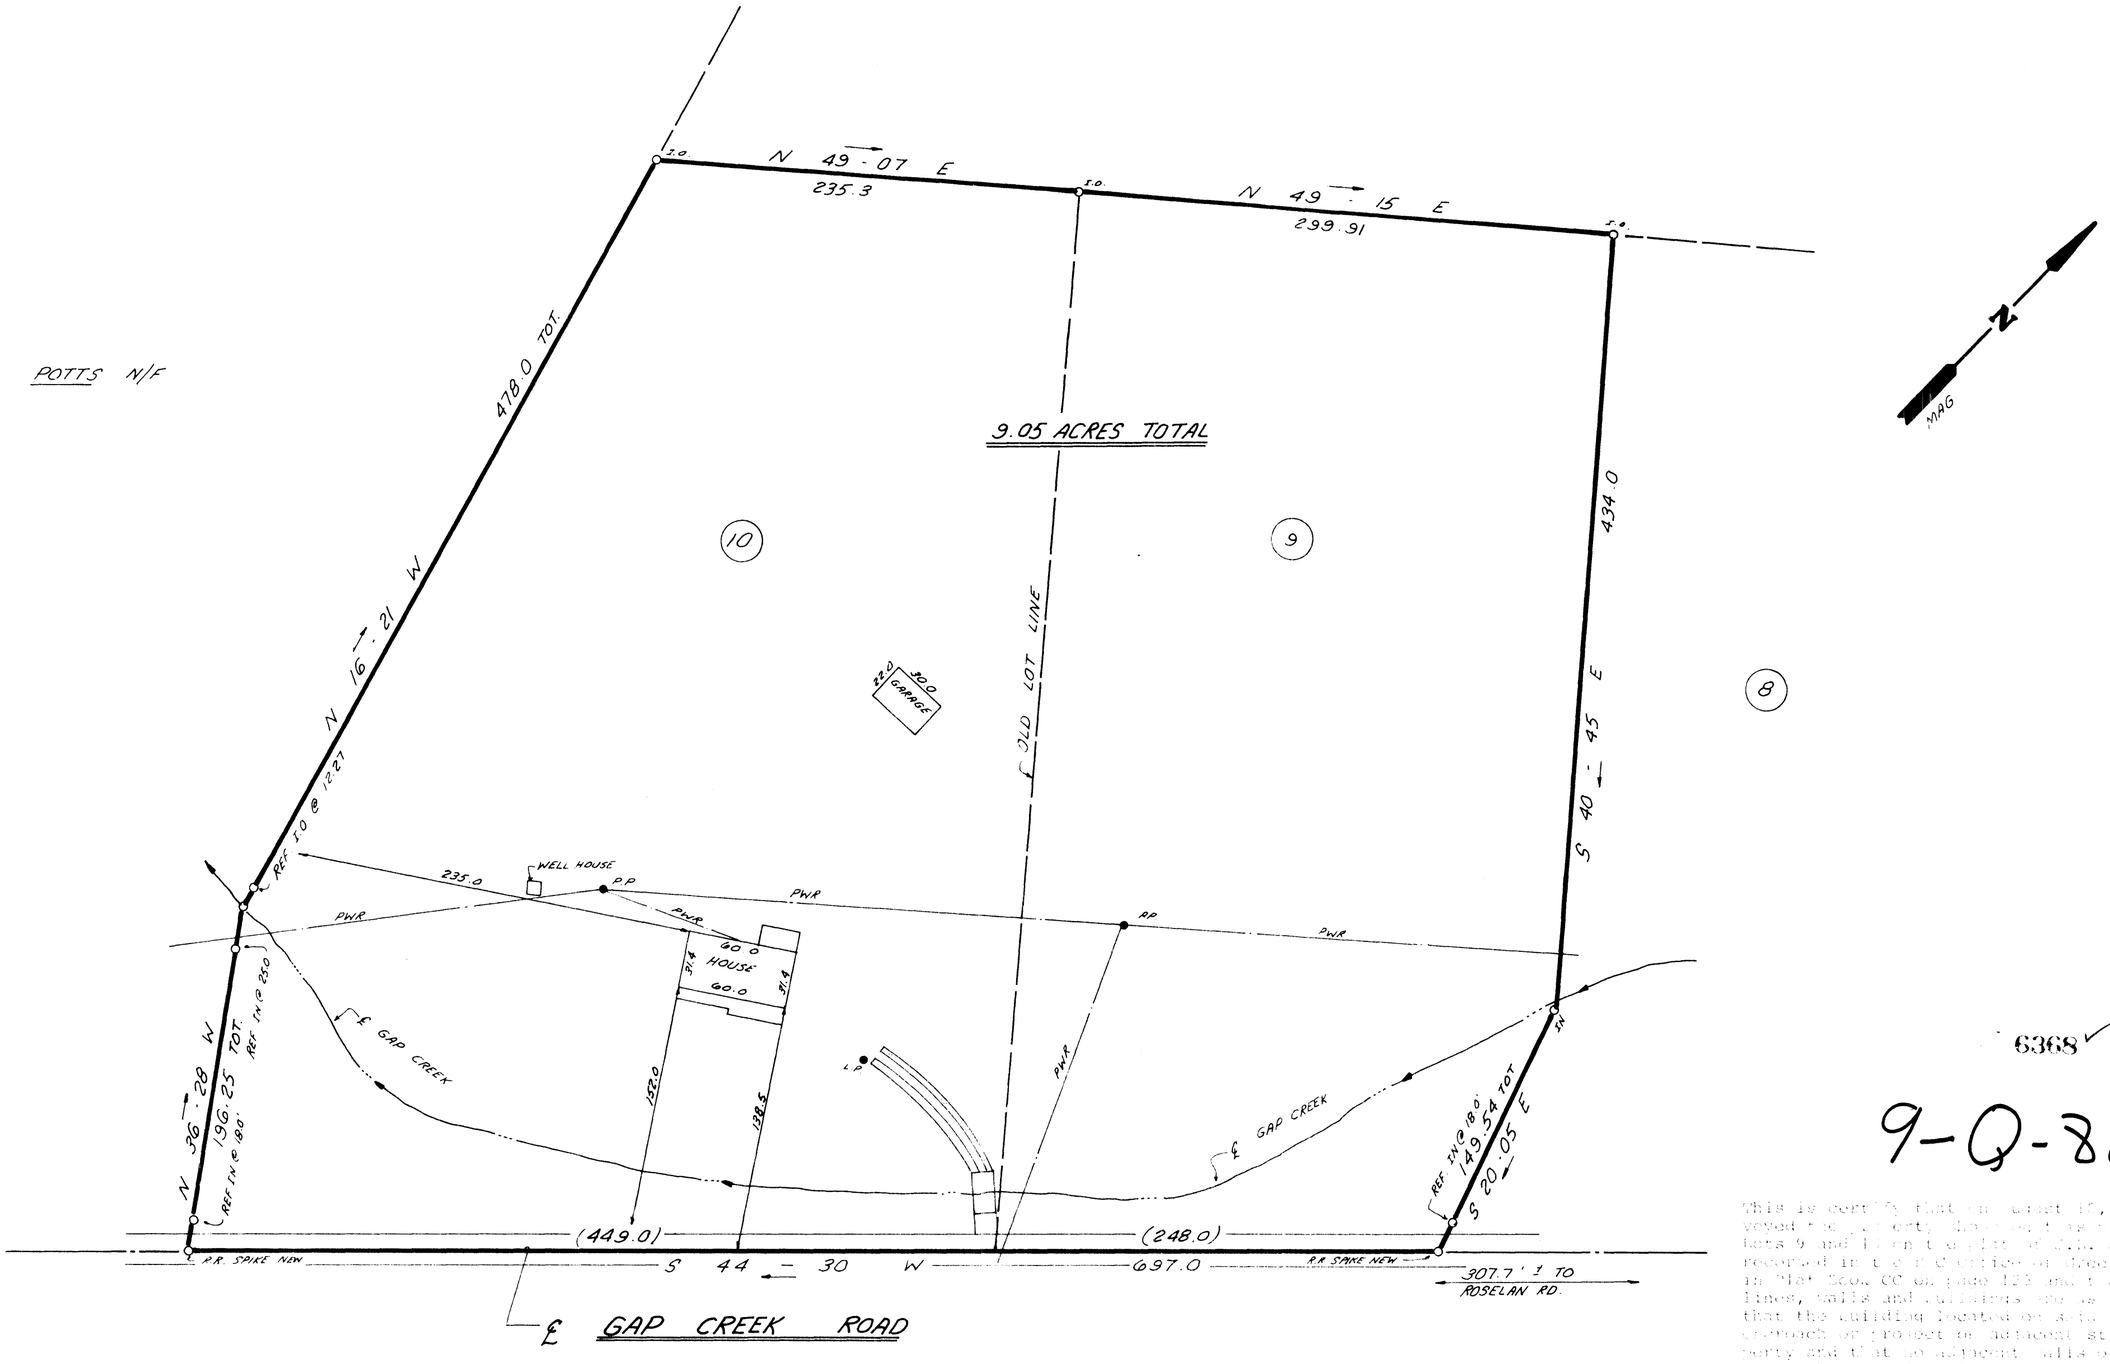

FILED
GREENVILLE CO. S.C.
AUG 23 3 57 PM '83
DONNIE S. TANKERSLEY
R.M.C.

6368

9-Q-82

AUG 23 1983

This is certify that on August 18, 1983, I surveyed the property shown on this plat, known as Lots 9 and 10 on the plat of J.L. Johnson Property, recorded in the R.C. Office of Greenville County in Plat Book CC on page 125 and that the property lines, walls and buildings are as shown hereon; that the building located on said lot does not encroach or project on adjacent streets or property and that no adjacent walls or buildings encroach or project on said premises, and that no utility lines cross this property except as shown hereon. This property is not located in a designated flood hazard area.

James R. Freeland
James R. Freeland REG. No. 4781

60 0 60 120
scale feet

SOUTH CAROLINA REGISTERED LAND SURVEYOR NO. 4781 JAMES RALPH FREELAND
SEAL

STATE OF SOUTH CAROLINA
GREENVILLE COUNTY

J.L. JOHNSON PROPERTY
LOTS 9 & 10
PROPERTY OF
KENNETH T. MORRIS &
MADELYNN H. MORRIS

FREELAND & ASSOCIATES
Engineers • Land Surveyors
GREENVILLE, S.C.

SURVEY	D.G.
DRAWN	K.E.G.
CHECK	M.C.
SCALE	1" = 60'
DATE	8-18-83
DWG. NO.	9594

MICROFILMED