
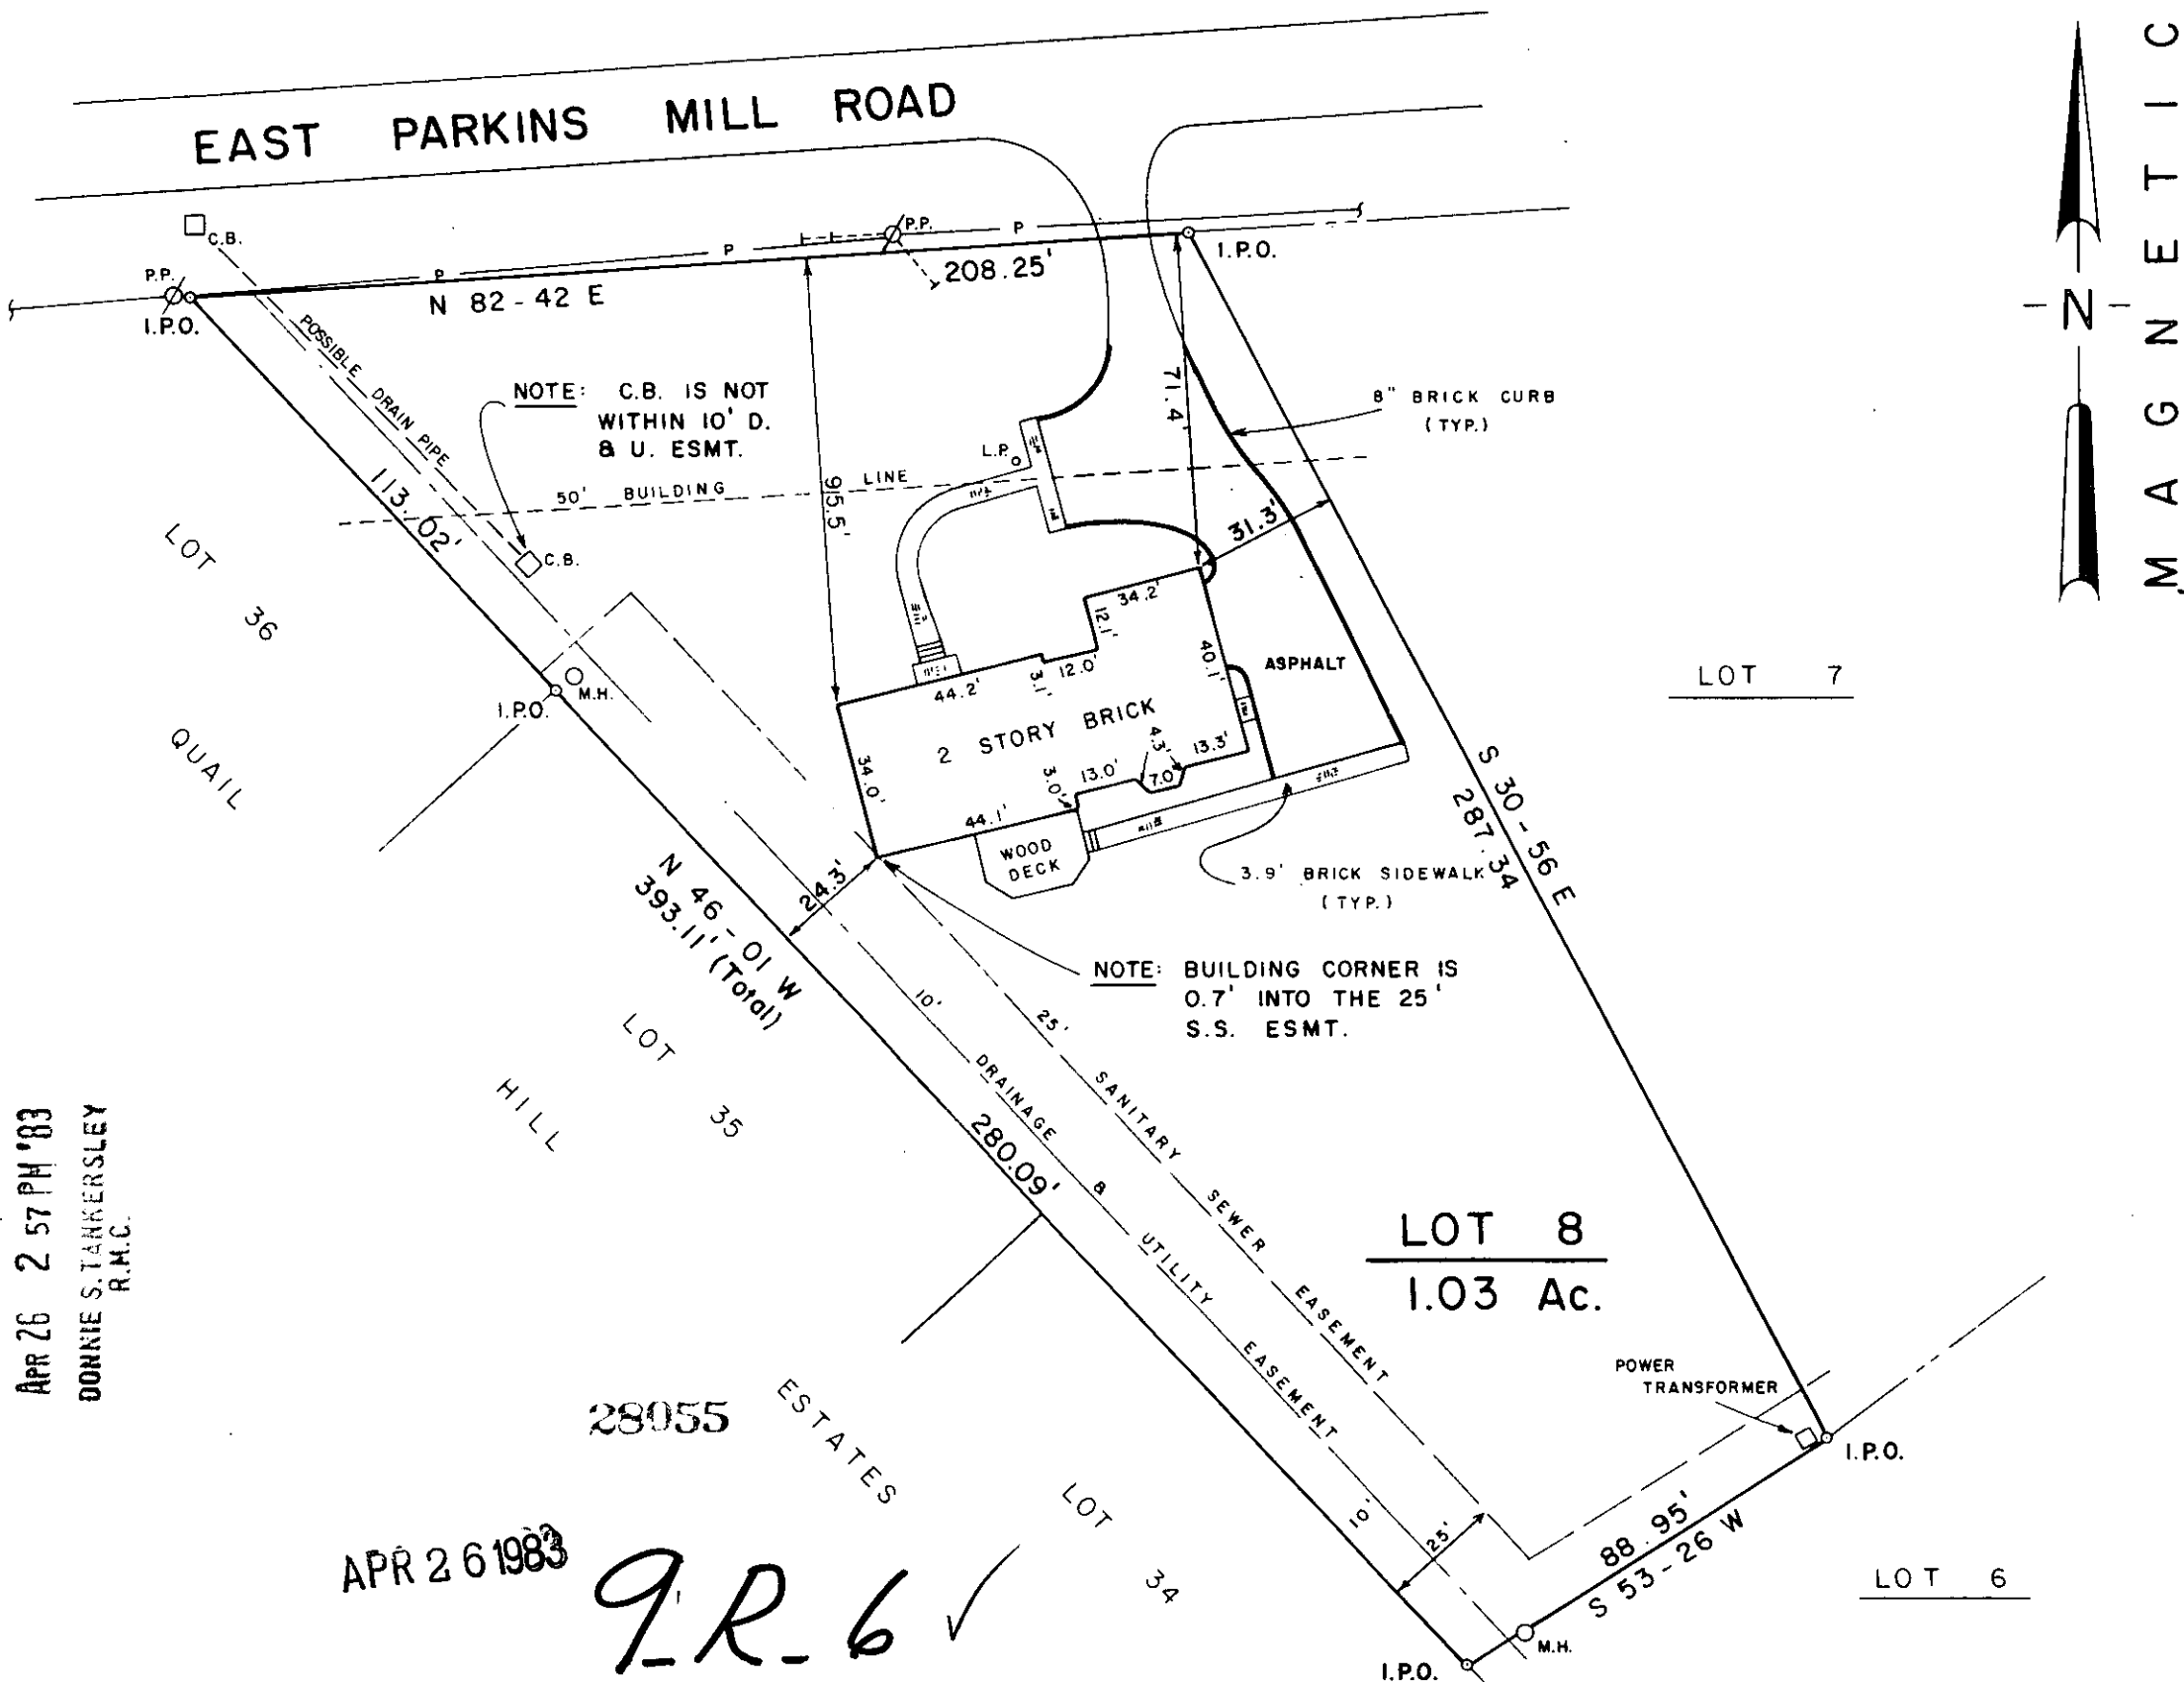


NOTES
 1. THERE IS A 5' UTILITY AND DRAINAGE EASEMENT ALONG EACH SIDE OF ALL SIDE PROPERTY LINES, AND A 5' EASEMENT ALONG EACH SIDE OF REAR PROPERTY LINES.

REVISIONS AND RECERTIFICATIONS					
NO	BY	DATE	DESCRIPTION	JOB NO. REFERENCE	APP
1					
2					
3					
4					

REFERENCES					
BB	M14.2-1-62	DB	1168-491	PB	7C-78
BB	M14.2-1-59	DB	1069-92	PB	TTT-201
BB	M14.2-1-60	DB	935-97	PB	4N-53
BB	M14.2-1-64	DB	1132-916	PB	7C-78

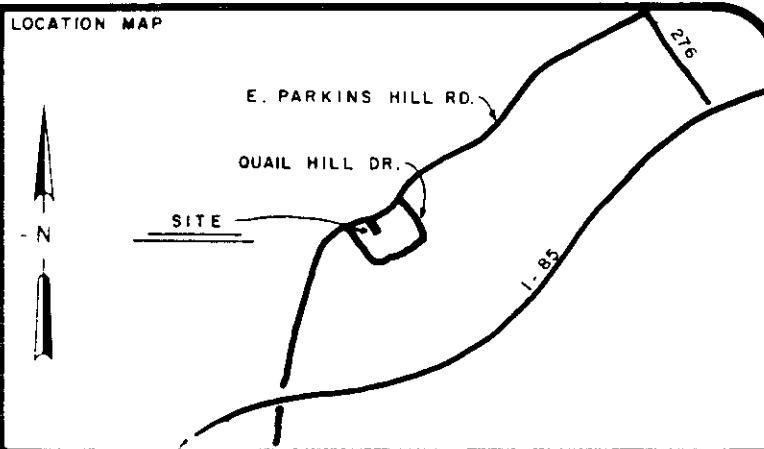

CERTIFICATION
 THIS IS TO CERTIFY TO A.F. B.M.P. McKISSICK THAT AN ACTUAL FIELD SURVEY WAS PERFORMED ON THIS PROPERTY UNDER MY SUPERVISION AND I DECLARE THAT:
 (1) THE FIELD SURVEY AND THIS PLAT REPRESENT A DEPENDENT RESURVEY OF THE SUBJECT PROPERTY AND THAT THE INFORMATION SHOWN HEREON IS CORRECT TO THE BEST OF MY PROFESSIONAL KNOWLEDGE AND BELIEF.
 (2) ALL RIGHTS OF WAY, EASEMENTS AND ENCROACHMENTS, OBVIOUS AND APPARENT FROM FIELD OBSERVATION OF THE SUBJECT PROPERTY AT THE TIME OF THE SURVEY ARE AS SHOWN.
 (3) THE AREA OF THE SUBJECT PROPERTY WAS CALCULATED BY COORDINATES AND THAT THIS IS A CLASS B SURVEY.
Thomas A. Darrett 4/22/83 8812
 SIGNATURE OF REGISTERED LAND SURVEYOR DATE S.C. REG. NO.

THIS IS TO CERTIFY TO _____ THAT THIS DRAWING IS A COMPOSITE PLAT AND DOES NOT CONSTITUTE AN ACTUAL FIELD SURVEY, AND THAT ANY USE OF THIS DRAWING FOR ANY PURPOSE OTHER THAN GENERAL REFERENCE IS DONE SO WITH THE UNDERSTANDING THAT ARBOR ENGINEERING INC. ASSUMES NO RESPONSIBILITY OR LIABILITY FOR ITS ACCURACY OR CORRECTNESS.
 SIGNATURE OF REGISTERED LAND SURVEYOR DATE S.C. REG. NO.

THE DEPARTMENT OF HOUSING AND URBAN DEVELOPMENT FLOOD WAY DATA FOR GREENVILLE COUNTY SHOWS THIS PROPERTY TO BE IN A FLOOD PLAIN AREA NOT TO BE IN A FLOOD PLAIN AREA LOCATION CANNOT BE DETERMINED.

PROPERTY SURVEY FOR
ANTHONY FOSTER McKISSICK, III
 and
MURRAY P. McKISSICK
LOT 8, QUAIL HILL II
 GREENVILLE SOUTH CAROLINA

SCALE 40 20 0 40 80
 1" = 40'

RESEARCH	WCM	DRAWN	DPB	CHECK	TAG	DATE	22 APRIL 83
FILE		FIELD WORK BY	WCM/DPB	JOB NO.	83100		

ARBOR ENGINEERING
 P.O. BOX 263, GREENVILLE, S.C.
 LANDSCAPE ARCHITECTS-ENGINEERS-LAND SURVEYORS

FILED
 GREENVILLE CO. S.C.
 APR 26 2 57 PM '83
 DONNIE S. TANKERSLEY
 R.M.C.

APR 26 1983

9.R.6 ✓