


GOWER STREET
WATER & SEWER IN ST. R/W

FILED
GREENVILLE CO. S.C.
MAY 2 12 11 PM '83
DONNIE S. TANKERSLEY
R.M.C.
22 P.

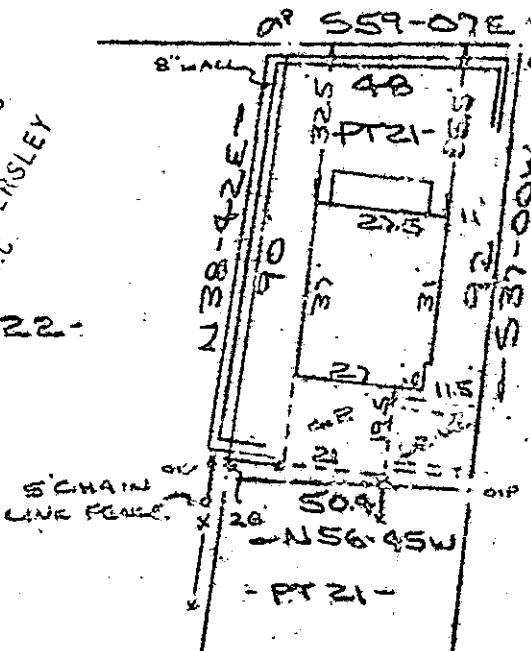

LINDBERGH Street
WATER & SEWER IN ST. R/W

Note: Improvements on this lot are not in a flood hazard area.

PROPERTY OF

CARROLL M. WILLIAMS & JUDY P. WILLIAMS
GREENVILLE, S.C.
27 APR 9 1983

This is to certify that on the 27th day of April, 1983, I surveyed the property herein on this date, being known as part of lot 21 on plat of PROPERTY OF LINDBERGH, S.C. and recorded in the R.R. Office Greenville County, S. C., in Plot Book #26 at Page 107; and that the property lines, walls and buildings are as shown hereon, and that the walls and buildings located on said lot do not encroach or project on adjacent street or property, and that no adjacent walls or buildings encroach or project on said premises, and no power lines cross this property except as shown hereon.

216

✓

9-S-20

MAY 2 1983

R. B. Bruce
R. B. Bruce, RLS #1952

28731

CAROLINA SURVEYING CO.
112 Hanly St.
Greenville, S. C.

3.00CT