

FILED
 GREENVILLE CO. S.C.
 MAY 4 3 27 PM '83
 DONNIE S. TARKERSLEY
 R.M.C.


This is to certify that on April 20, 1983, I surveyed the property shown on this plat, known as Lot 5 on the plat of Forrester Woods, Sec. 7, 1983, recorded in the RMC Office of Greenville county in Plat Book 5P on page 21, and that the property lines, walls and buildings are as shown hereon; that the building located on said lot does not encroach or project on adjacent streets or property, and that no adjacent walls or buildings encroach or project on said premises, and that no utility lines cross this property except as shown hereon. This property is not located in a designated flood hazard area.

5' drainage & utility easement along all side and rear lot lines.

James R. Freeland
 James R. Freeland PE and RLS 4781



29062
 ✓ 9-5-34

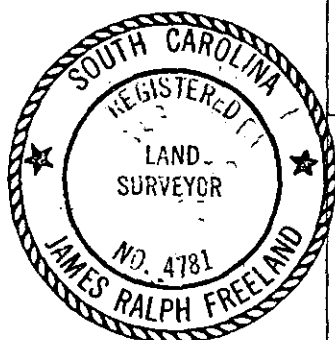

**STATE OF SOUTH CAROLINA
 GREENVILLE COUNTY**

FREELAND & ASSOCIATES
 Engineers • Land Surveyors
 GREENVILLE, S.C.

FORRESTER WOODS
"SEC. 7 ; LOT 5"
PROPERTY OF
KENNETH E. HUGGINS
LINDA E. HUGGINS MY 4 83

SURVEY D.G.
DRAWN B. R.
CHECK <i>JMF</i>
SCALE 1" = 40' 3.00CD
DATE APR. 20. 83
DWG. NO. 8795