AF 10505

MICROFILMED

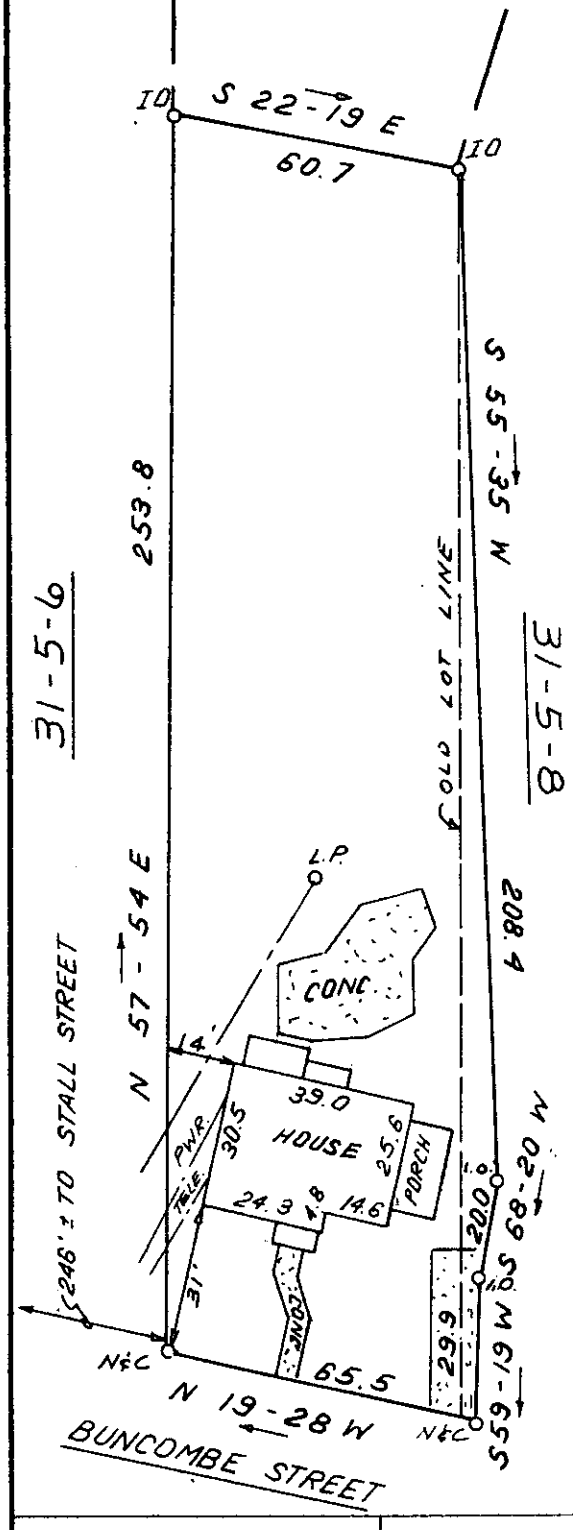

This is to certify that on May 5, 1983 , I surveyed the property shown on this plat, known as Property of Marie Fisher, recorded in the RMC Office of Greenville County in Plat Book TT on page 55, and that the property lines, walls and buildings are as shown hereon; that the building located on said lot does not encroach or project on adjacent streets or property, and that no adjacent walls or buildings encroach or project on said premises, and that no utility lines cross this property except as shown hereon. This property is not located in a designated flood hazard area.

James R. Freeland

James R. Freeland RLS PLS 4781

29602 MAY 9 1983

FILED
GREENVILLE CO. S.C.
MAY 9 2 33 PM '83
BONNIE S. TANNERSLEY
R.M.C.

9-S-51

31-5-7

MY 983 2.68

3.00 CI 9

SOUTH CAROLINA REGISTERED LAND SURVEYOR NO. 4781 JAMES RALPH FREELAND

SEAL

STATE OF SOUTH CAROLINA
GREENVILLE COUNTY

SURVEY FOR

WILLIAM A. CLEVELAND

& GLORIA T. CLEVELAND

FREELAND & ASSOCIATES
Engineers • Land Surveyors
GREENVILLE, S.C.

SURVEY	R.P.
DRAWN	B.R.
CHECK	MAC
SCALE	1" = 40'
DATE	5-5-83
DWG. NO.	83-8888