
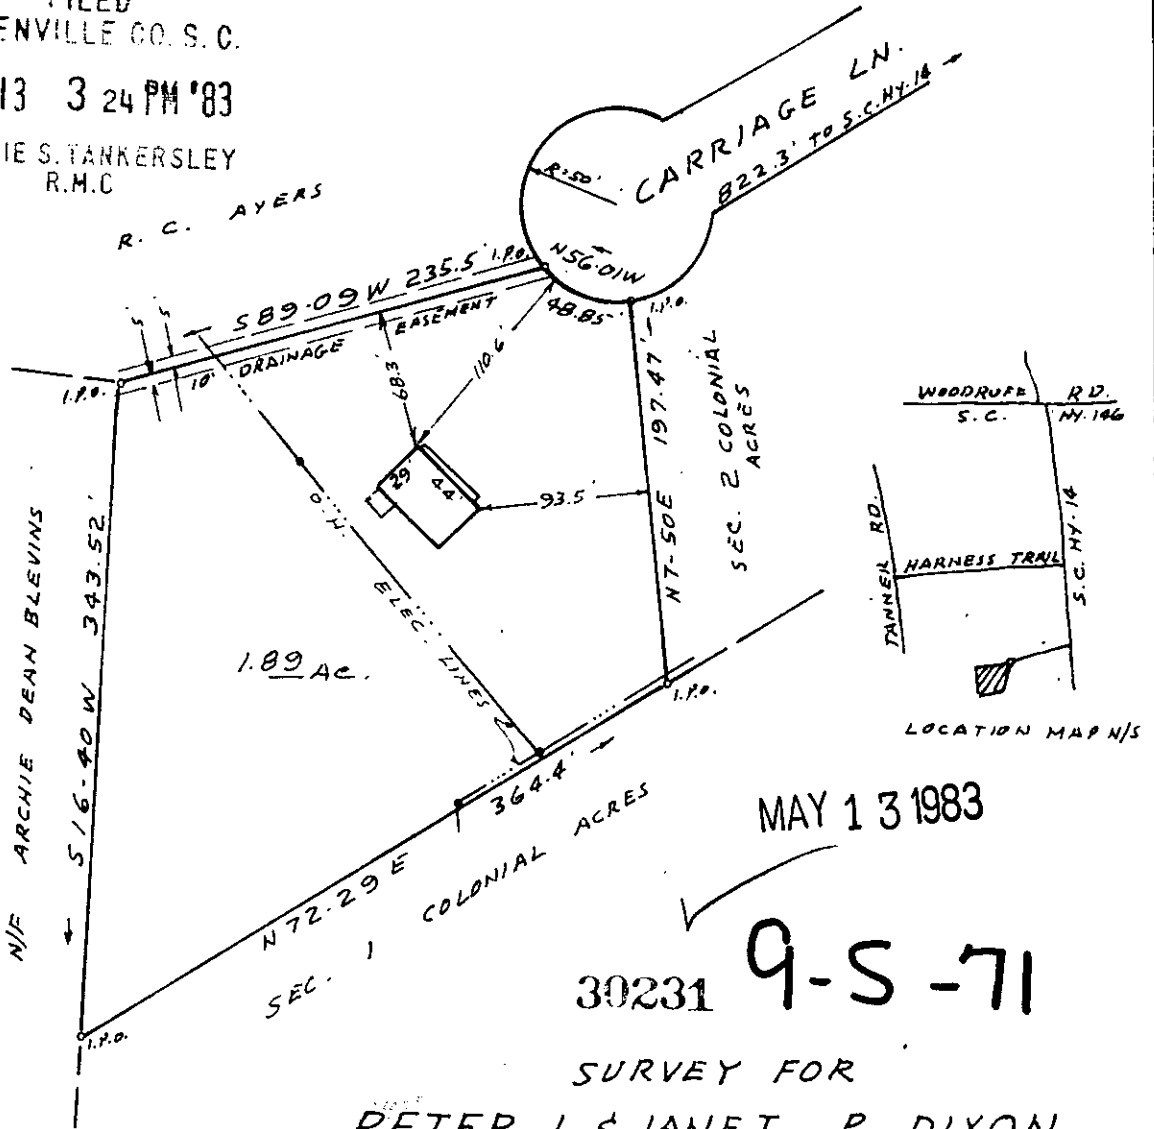


FILED
GREENVILLE CO. S. C.

MAY 13 3 24 PM '83

DONNIE S. TANKERSLEY
R.M.C.

R. C. AYERS

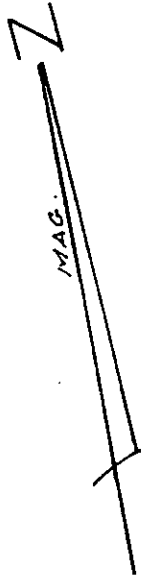

MAY 13 1983

30231

9-5-71

SURVEY FOR

PETER L. & JANET P. DIXON
NEAR GREENVILLE, S.C.

MAY 6, 1983

SCALE 1" = 100'

REF: PLAT OF R. C. AYERS PROP.
BY C. O. RIDGLE AUG. 21, 1979
RECORDED IN PLAT BOOK 7N PAGE 74.
TAL MAP 535-1-1-19.35

I certify that this is an accurate plat of a survey made by me May 6th. 1983, that the structures located on said premises do not encroach or project on adjacent streets or property, that there are no easements visible on the ground except as noted hereon, and that the structure located on said premises is not located in a 100 year flood plain.

0109

REC'D
MAY 13 1983
0500

3.000CD

C. O. Riddle

RLS # 1347, Greenville, S.C.

