


MICROFILMED

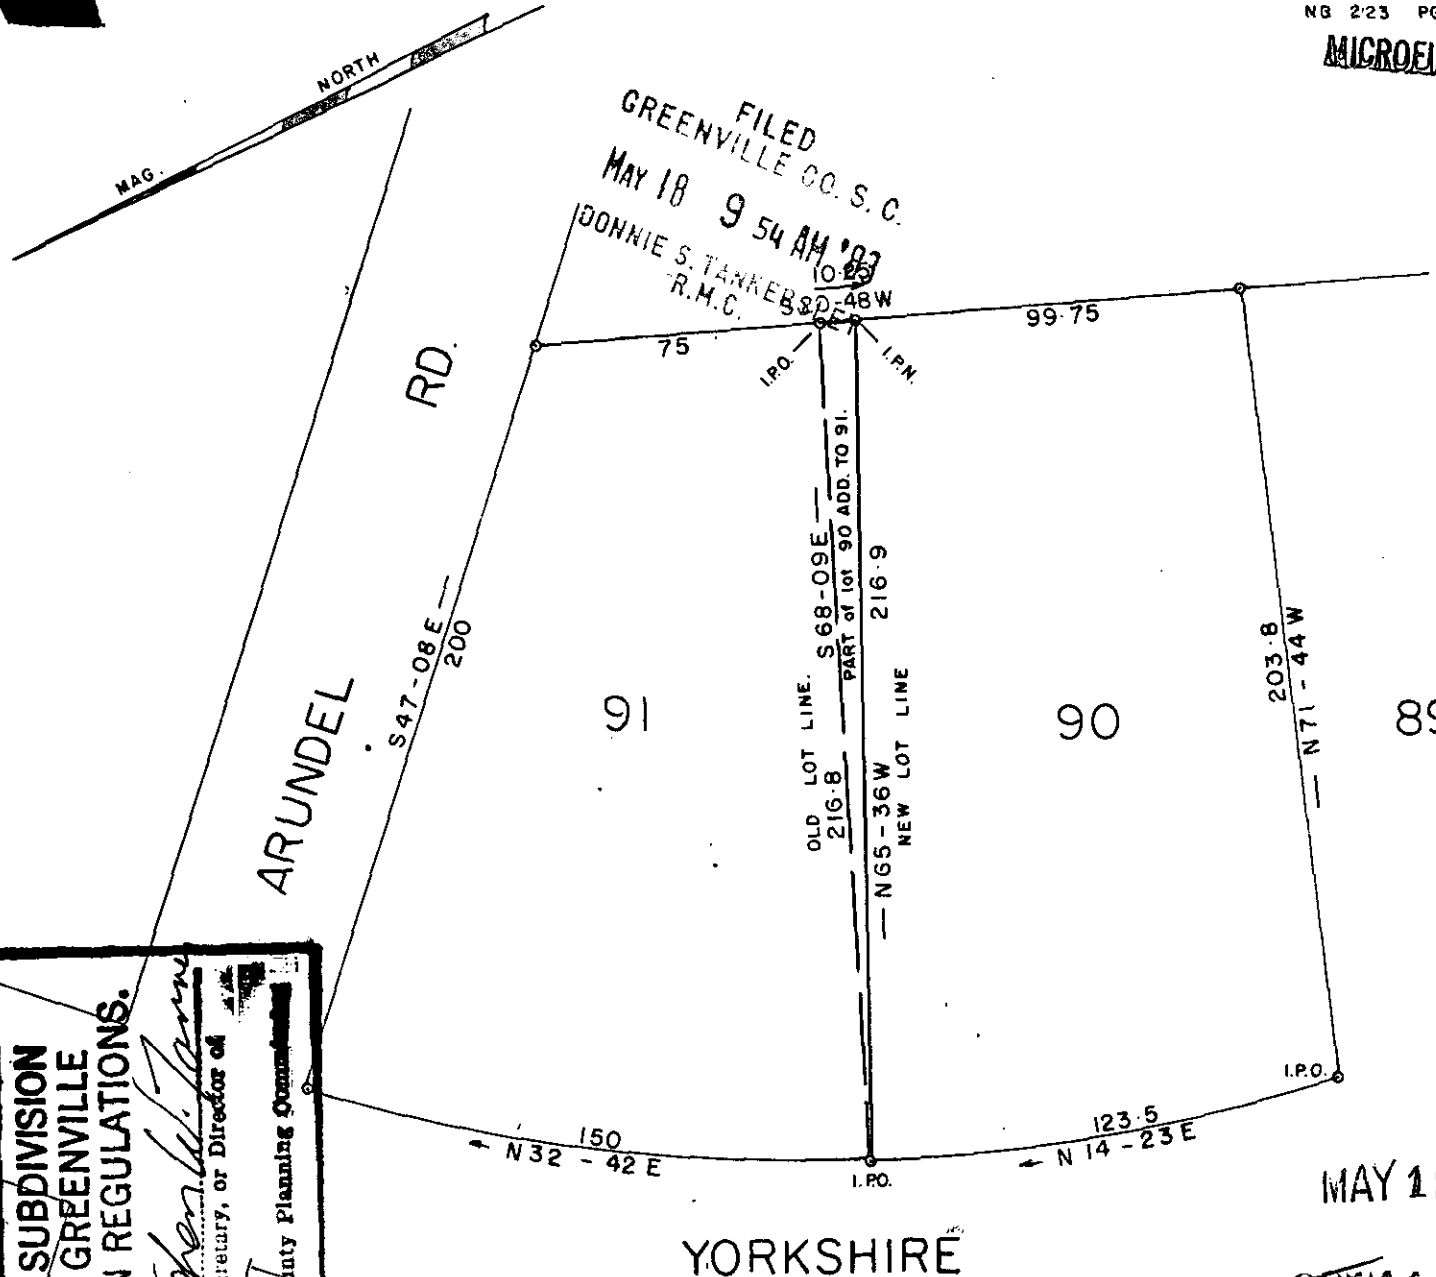

FILED
 GREENVILLE CO. S. C.
 MAY 18 9 54 AM '83
 DONNIE S. TANKEB
 R.M.C.

THIS PLAT IS NOT A SUBDIVISION AS DEFINED BY THE GREENVILLE COUNTY S.J. DIVISION REGULATIONS.

5/18/83 *Stephen W. Jones*
 Secretary, or Director of
 Planning
 Greenville County Planning Commission

MAY 18 1983

YORKSHIRE

30711
 9-5-84

NOTE: SEE PLAT Bk. II PAGE 120

REVISION OF LOTS 90 & 91

JAMES M. EDWARDS Prop.

GREENVILLE COUNTY, S. C.

APRIL - 28 - 1983

