
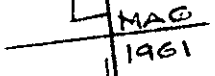


-THACKSTON (N/F)-

MICROFILMED

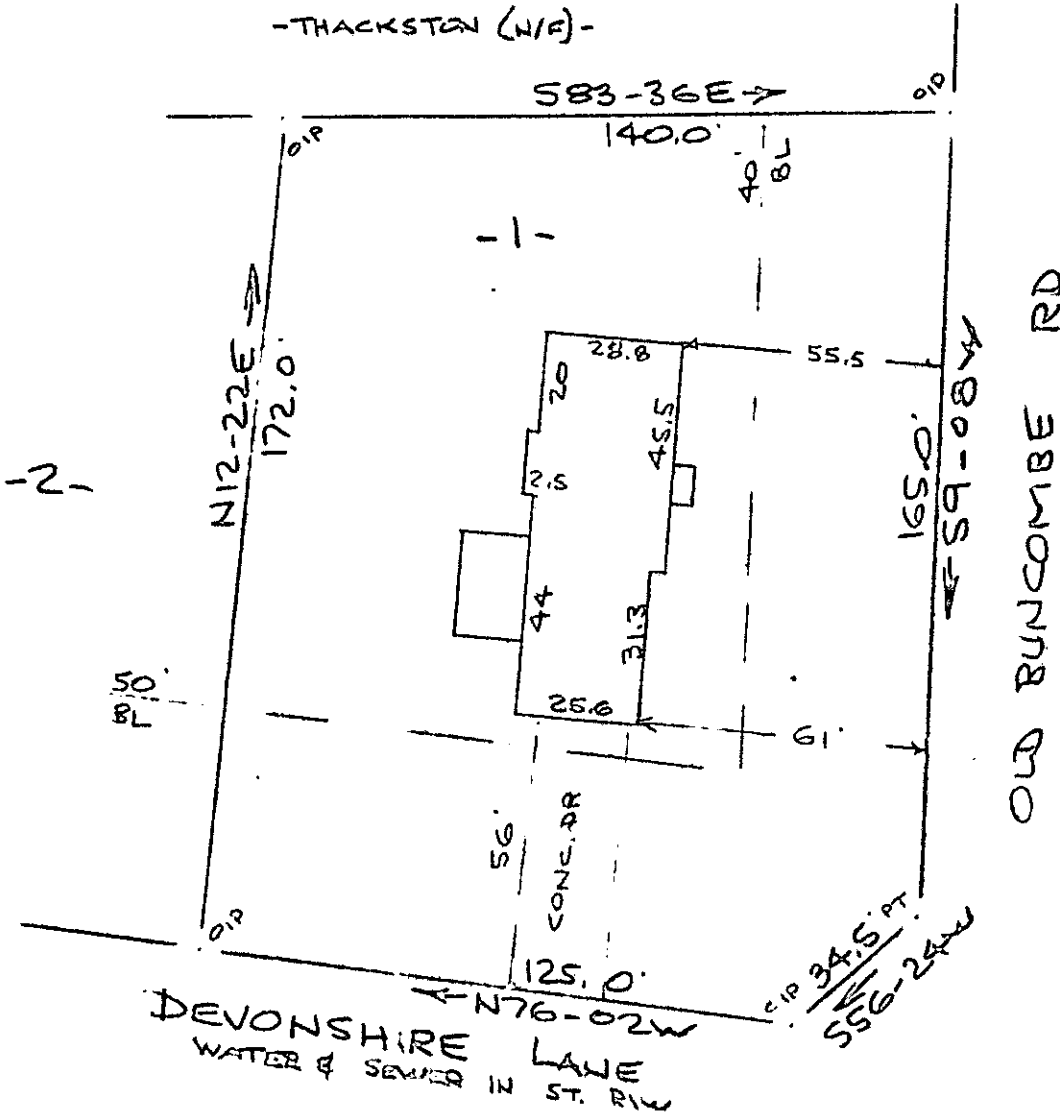

Note: Improvements on this lot are not in a flood hazard area.

FILED
 GREENVILLE CO. S. C.
 MAY 20 11 26 AM '83
 DONNIE S. JANKERSLEY
 R.M.C.

PROPERTY OF
 ROBERT E. BOLEVAARE & CLARETT E. BOLEWARE
 NEAR GREENVILLE, S. C.
 40 18 MAY 1983 90'

This is to certify that on the 18th day of May, 1983, I surveyed the property shown on this plat, being known as lot 1 on plat of NORTHWOOD HILLS SECTION 1 NORTHWOOD HILLS and recorded in the RMC Office Greenville County, S. C., in Plat Book "QQ" at Page 156; and that the property lines, walls and buildings are as shown hercon, and that the walls and buildings located on said lot do not encroach or project on adjacent street or property, and that no adjacent walls or buildings encroach or project on said premises, and no power lines cross this property except as shown hercon.

R. B. Bruce
 R. B. Bruce, RLS #1952

31034
 9.5.94

CAROLINA SURVEYING CO.
 112 Manly St.
 Greenville, S. C.
 GCTO -----3 MY20 83 066

3.00CD