



FILED
GREENVILLE CO. S.C.

MAY 27 2 49 PM '83

DONNIE S. TAYLOR
R.M.C.

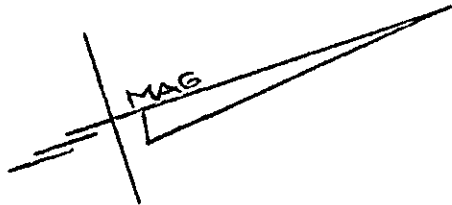

BROOKWOOD DR

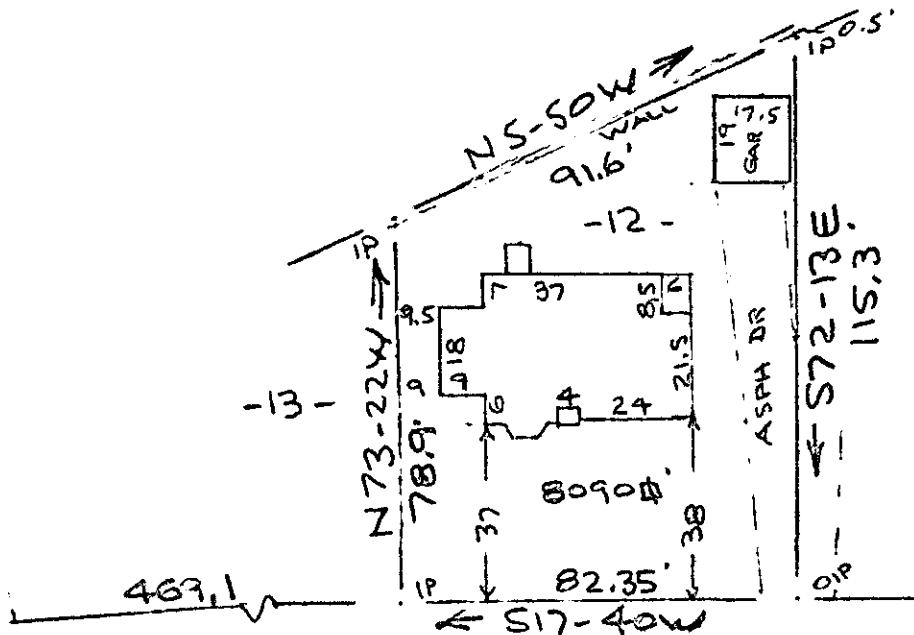

Note: Improvements on this lot are not in a flood hazard area.

MELVILLE AVE
WATER & SEWER IN ST. ROW

PROPERTY OF
DAVID M. ROPER & DEBRA P. ROPER
GREENVILLE, S.C.

APR 21 1983

ECTO -----3 MY27 83 099

This is to certify that on the 21st day of April, 1983, I surveyed the property shown on this plat, being known as lot 12 on plat of PROPERTY OF DAVID M. ROPER & DEBRA P. ROPER and recorded in the REC Office Greenville County, S. C., in Plat Book _____ at Page _____; and that the property lines, walls and buildings are as shown hereon, and that the walls and buildings located on said lot do not encroach or project on adjacent street or property, and that no adjacent walls or buildings encroach or project on said premises, and no power lines cross this property except as shown hereon.

✓ 9-T-32

31840

R. B. Bruce

R. B. Bruce, RLS 61952

CAROLINA SURVEYING CO.
112 Manly St.
Greenville, S.C.

3.0000