MICROFILMED

FILED
GREENVILLE CO S.C.
MAY 27 2 58 PM '83
DONNIE S. TANKERSLEY
R.M.C

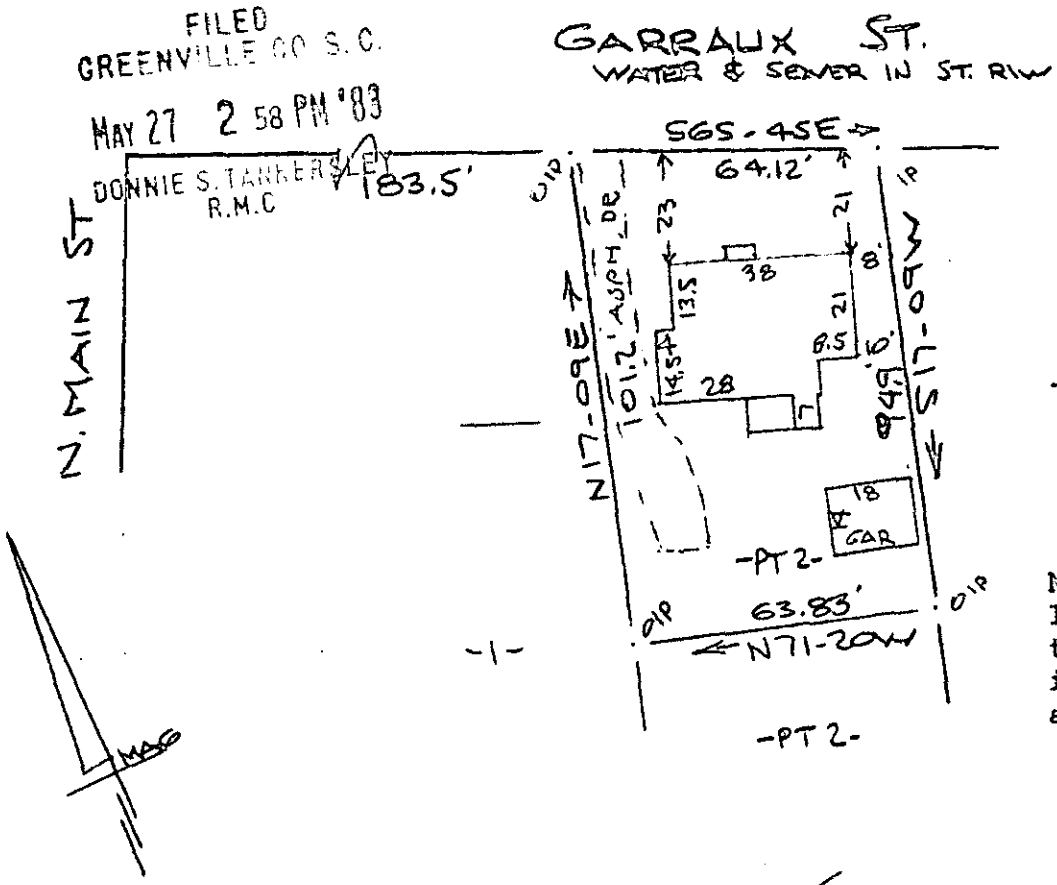


Note:
Improvements on this lot are not in a flood hazard area.

31839

9-T-33

MAY 27 1983

PROPERTY OF
GARY R. PATTERSON & JO S. PATTERSON
GREENVILLE, S.C.
26 MAY 1983

This is to certify that on the 26th day of May, 1983, I surveyed the property shown on this plat, being known as part of lot 2 on plat of SECTION " F " STONE LAND CO. and recorded in the RMC Office Greenville County, S. C., in Plat Book " K " at Pages 277 also known as PROPERTY OF GARY R. PATTERSON & JO S. PATTERSON and recorded in Plat Book at Page ; and that the property lines, walls and buildings are as shown hereon, and that the walls and buildings located on said lot do not encroach or project on adjacent street or property, and that no adjacent walls or buildings encroach or project on said premises, and no power lines cross this property except as shown hereon.

R. B. Bruce

R. B. Bruce, RLS #1952

CAROLINA SURVEYING CO.
112 Manly St.
Greenville, S. C.

98/64 35-3-7 300 3 4058-1.A01