


Note:  
Improvements on  
this lot are not  
in a flood  
hazard area.

-N/E J.S. JONES-

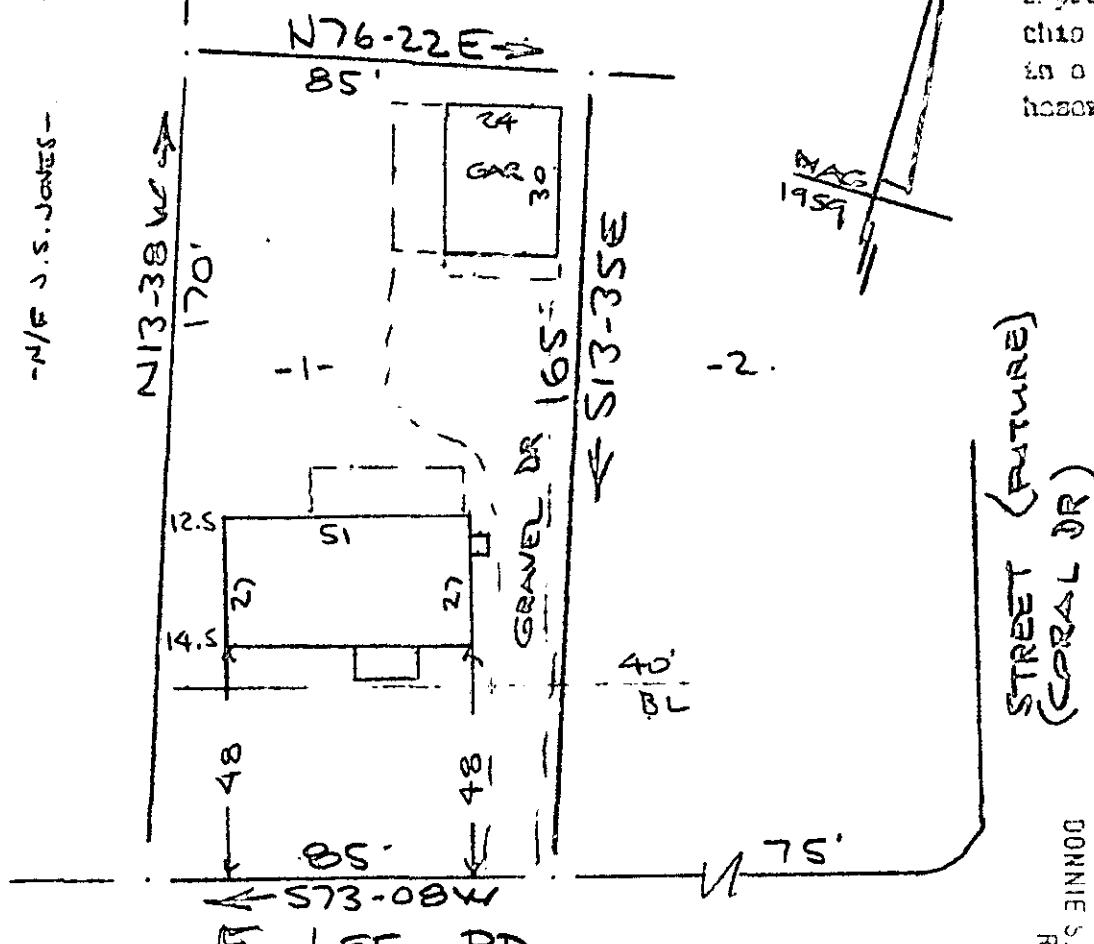

E. LEE RD.  
WATER & SEWER IN ST. R/W

PROPERTY OF  
IONE M. PARSONS  
NEAR GREENVILLE, S.C.  
40 30 MAY 0 1983 40'

FILED  
GREENVILLE CO. S.C.

MAY 31 1983  
DONNA S. TANKERSLEY  
R.M.C.

This is to certify that on the 30th day of May, 1983, I surveyed the property shown on this plan, being known as lot 1 on plan of PROPERTY OF JACK L. SILVY and recorded in the RMC Office Greenville County, S. C., in Plat Book "T" page 103; and that the property lines, walls and buildings are as shown herein, and that the walls and buildings located on said lot do not encroach or project on adjacent street or property, and that no adjacent walls or buildings encroach or project on said premises, and no power lines cross this property except as shown herein.

MAY 31 1983

32156

R. B. Brinkley  
R. B. Brinkley, A.I.D. #1952  
1/1952

9-T-58

CAROLINA SURVEYING CO.

112 Monty St.

Greenville, SC  
Octo --- 23 MY31 83

015

3.00CD