

PROPERTY OF
PAUL J. VOYER
SHIRLEY G. VOYER
 GREENVILLE COUNTY, S.C.

GREENVILLE CO. S.C.
 JUN 1 3 24 PM '83
 DONNIE S. JANKERSLEY
 R.M.C.

FILED


Scale 1" = 40' May, 1983.

This is to certify that on the 26th day of May, 1983, We surveyed the property shown on this plat; being shown as an unnumbered lot on plat of North Park, Recorded in Plat Book K, pages 48 & 49 and part Lot 53 on plat of North Hills, Recorded in Plat Book H page 136, Office of R. M. C. Greenville Co., S.G.; and that the property lines, walls and buildings are as shown hereon; that the buildings located on said lots do not encroach or project on adjacent streets or property; and that no adjacent buildings or walls encroach or project on said premises; and from information from Greenville County, this structure is not located in a designated flood area.

CGCTO -----3 JUN 183 063

32466

R. W. L. Saxon
 DALTON & NEVES CO., ENGINEERS

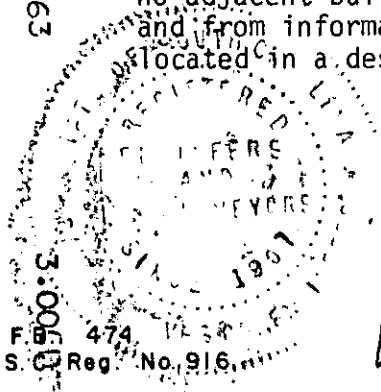

V9-T-78

JUN 1 1983