Note: Improvements on this lot are not in a flood hazard area.

MICROFILMED

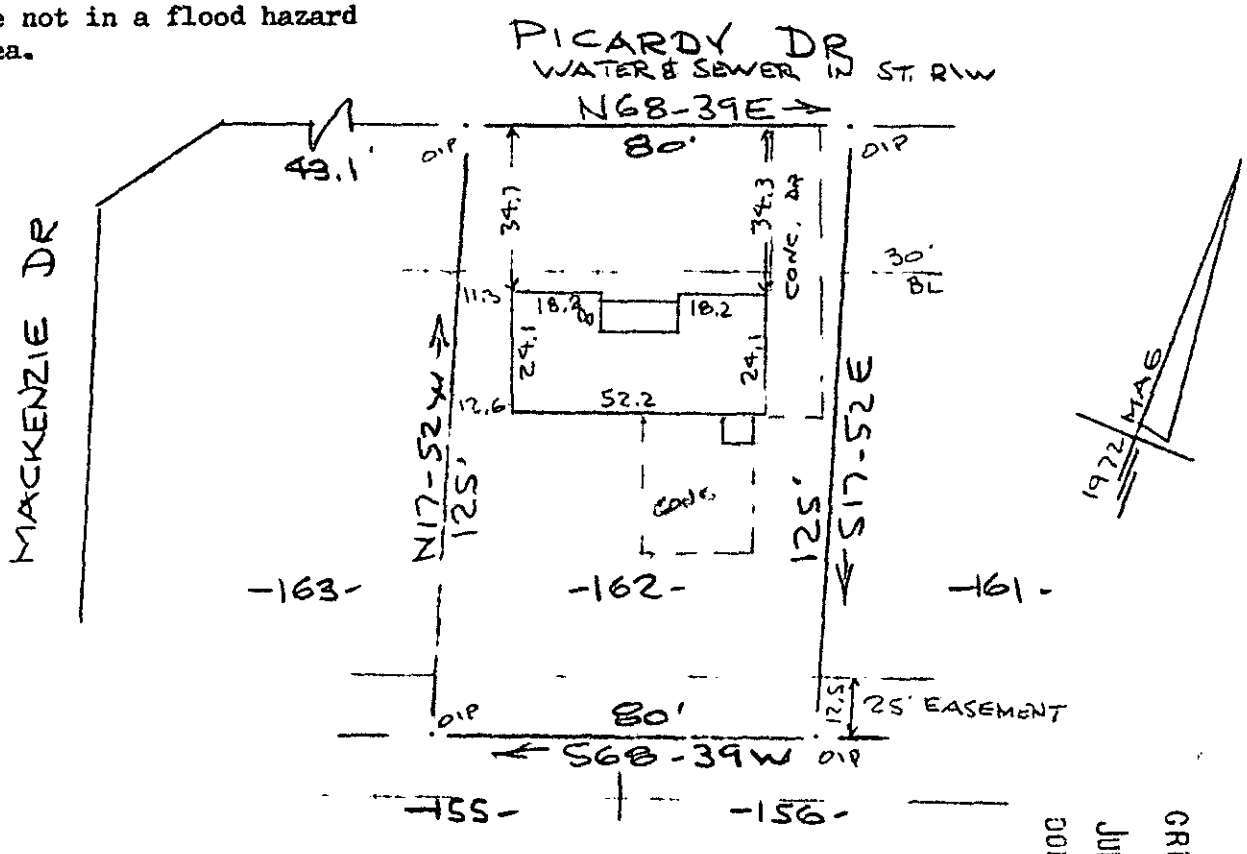


FILED
GREENVILLE CO. S. C.
JUN 3 10 21 AM '83
DONNIE S. TANKERSLEY
R.M.C.

PROPERTY OF
LEE ROY BARKSDALE & MALINDA GAIL BARKSDALE
NEAR GREENVILLE, S.C.
40' 26 MAY 0 1983 40'

This is to certify that on the 26th day of May, 1983, I surveyed the property shown on this plat, being known as lot 162 on plat of IDLEWILD and recorded in the RMC Office Greenville County, S. C., in Plat Book " 4 - N " at Page 54; and that the property lines, walls and buildings are as shown hereon, and that the walls and buildings located on said lot do not encroach or project on adjacent street or property, and that no adjacent walls or buildings encroach or project on said premises, and no power lines cross this property except as shown hereon.

9-T-83 JUN 3 1983

R. B. Bruce, RLS #1952

32733

CAROLINA SURVEYING CO.
112 Manly St.
Greenville, S. C.

STATE OF SOUTH CAROLINA
REGISTERED LAND SURVEYOR
R. B. BRUCE
NO. 1952

STU 3 JUN 3 83 029 3.00CD

257/5

593.5-1-162