
3.00 з

421/88931

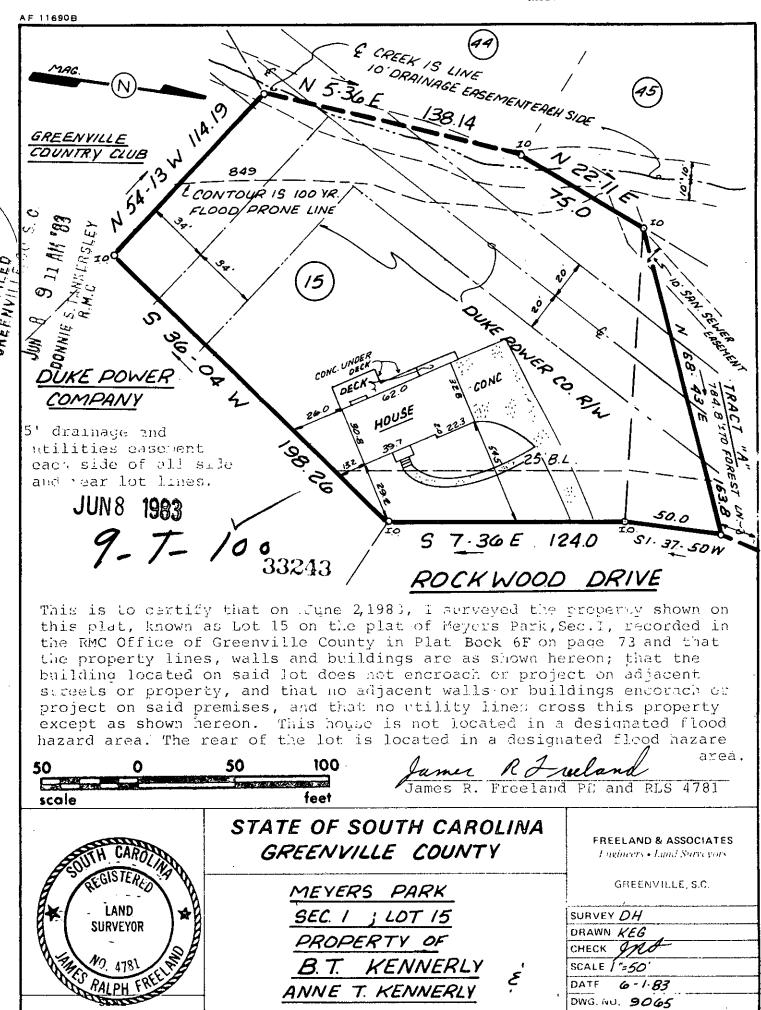

PRINT MACHINE INC.