



This is to certify that on May 5, 1983, I surveyed the property shown on this plat, known as Lot 45 on the plat of Meyers Park, Sec. II, recorded in the RMC Office of Greenville County in Plat Book 5P on page 54 and that the property lines, walls and buildings are as shown hereon; that the building located on said lot does not encroach or project on said premises and that no utility lines cross this property except as shown hereon. The rear of the lot is in a designated flood hazard area.

*James R. Freeland*  
 James R. Freeland PE and RLS  
 4781

There is a drainage & utility easement 5' each side of all side and rear lot lines.

33410

9-6-11

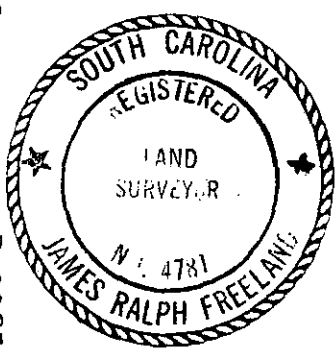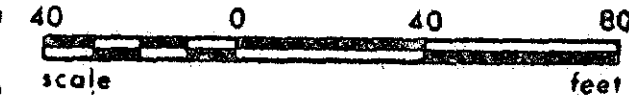

STATE OF SOUTH CAROLINA  
 GREENVILLE COUNTY

MEYERS PARK  
SEC. 2 ; LOT 45  
PROPERTY OF  
DR. JERRY LANGLEY

FILED  
 GREENVILLE S.C.  
 JUN 9 3 28 PM '83  
 DONNIE S. LANGRISH  
 R.M.C. GREENVILLE, S.C.

SURVEY J.C.  
 DRAWN KEG.  
 CHECK *JK*  
 SCALE 1"=40'  
 DATE 5-4-83  
 DWG. NO. 8890