

"THIS PLAT TO BE RECORDED
IN THE R.M.C. OFFICE."

"THIS PROPERTY IS NOT LOCATED IN A FLOOD PLAIN." PER N.G.S.

MICROFILMED

FILED
GREENVILLE CO. S. C.

JUN 10 3 51 PM '83

DONNIE S. HARRISLEY
R.M.C.

MAGNETIC NORTH

$S^{\circ}87^{\circ}14'E$ 135.1... L.P.F.

- 142 -

- 143 -

- 144 -

N 3-49W 228.5

222.48

S 5-05W

38.7

35.6

30' B. LINE

37.0

42.6

N 89-55W 100.0

L.P.F.

- BRENTWOOD WAK -

"WATER & SEWER IN R.W."


JUN 10 1983

9-2-15

EDWIN APPEL
SUSAN T. APPEL

33551

THIS IS TO CERTIFY THAT ON THE 10TH DAY OF MAY 1983,
I SURVEYED THE PROPERTY SHOWN ON THIS PLAT BEING LOT # 143 ON PLAT OF
BRENTWOOD WAK AND HOLDING IN THE R.M.C. OFFICE GREENVILLE
COUNTY IN FLAT BOOK B-11 PAGES 43; AND THAT THE
PROPERTY LINES, WALLS, AND BUILDINGS ARE SHOWN HEREON, AND THAT THE WALLS AND BUILD-
INGS LOCATED ON SAID LOT DO NOT ENCR OACH OR PROJECT ON ADJACENT STREETS OR PROPERTY,
AND ADJACENT WALLS OR BUILDINGS ENCR OACH OR PROJECT ON SAID PREMISES, AND NO
POWER LINES CROSS THIS PROPERTY EXCEPT AS SHOWN HEREON.

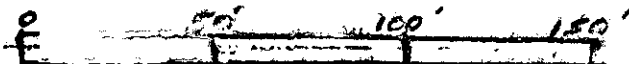

"THIS IS TO CERTIFY THAT THE ERROR OF CLOSURE OF THIS
SURVEY IS 0.0002, AND THE ACREAGE HAS BEEN
DETERMINED BY THE D.M.D. METHOD." P.L.M.-E

SEVENTH DAY OF MAY 1983
SOUTH CAROLINA
REGISTERED
D.L. MONTGOMERY
R. L. S. No. 4562
Simpsonville, S. C.

300 3 42731A01