


MICROFILMED

OAK HOLLOW SEC. 2

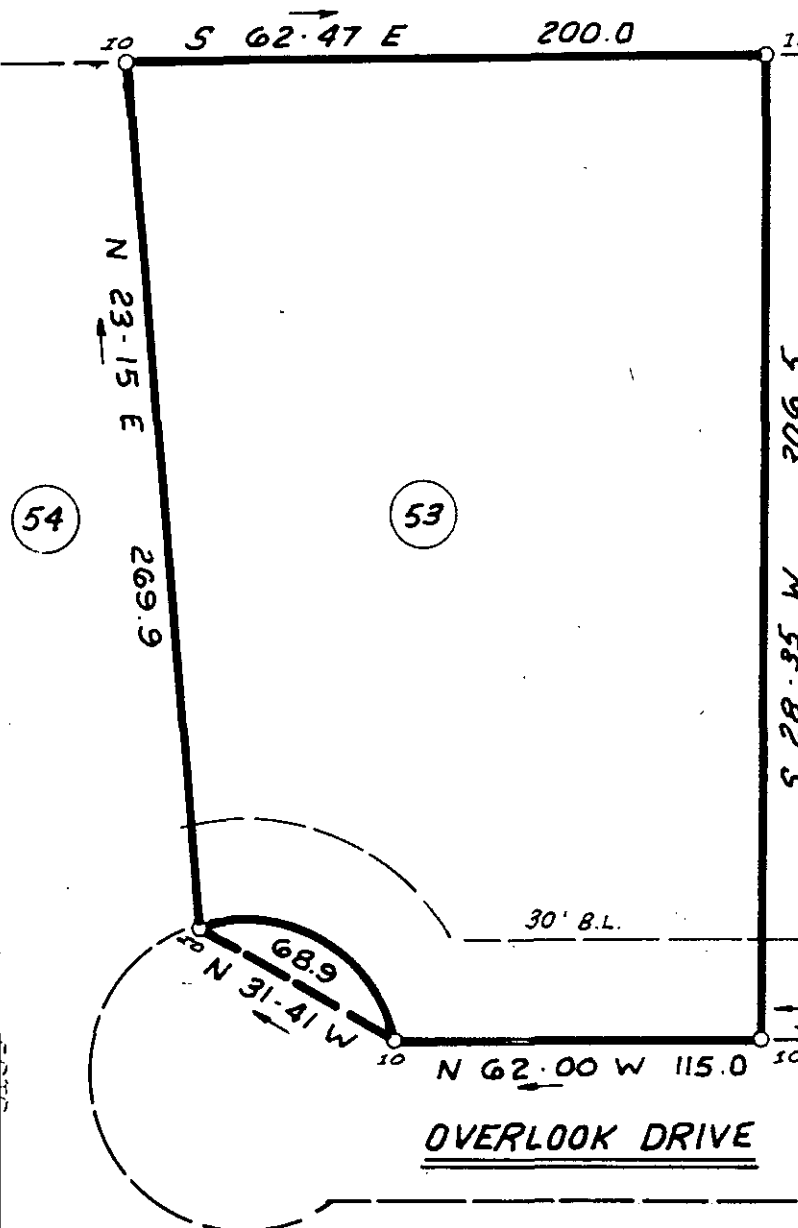

FILED  
 GREENVILLE CO. S.C.  
 JUN 20 4 13 PM '83  
 DONNIE S. TANKERSLEY  
 R.M.C.

This is to certify that on June 17, 1983, I surveyed the property shown on this plat, known as Lot 53 on the plat of Oak Hollow, Sec.3, recorded in the RMC Office of Greenville County in Plat Book 7X on page 61 and that the property lines, walls and buildings are as shown hereon; that the building located on said lot does not encroach or project on adjacent streets or property and that no adjacent walls or buildings encroach or project on said premises, and that no utility lines cross this property except as shown hereon. This property is not located in a designated flood hazard area.

*James R. Freeland*  
 James R. Freeland PE  
 and RLS 4781

9-2-43

5' drainage & utility easement along all rear & side lot lines.

34546 JUN 20 1983



005  
 012083  
 020



STATE OF SOUTH CAROLINA  
 GREENVILLE COUNTY

OAK HOLLOW  
 SEC. 3 ; LOT 53  
 PROPERTY OF  
 JAMES M. SIKORA

FREELAND & ASSOCIATES  
 Engineers • Land Surveyors

GREENVILLE, S.C.

SURVEY	C.T.
DRAWN	K.E.G.
CHECK	MC
SCALE	1" = 60'
DATE	6-17-83
DWG. NO.	9177