MICROFILMED

FILED
GREENVILLE CO. S.C.
JUN 29 12 49 PM '83
DONNIE S. TANKERSLEY
R.M.C.

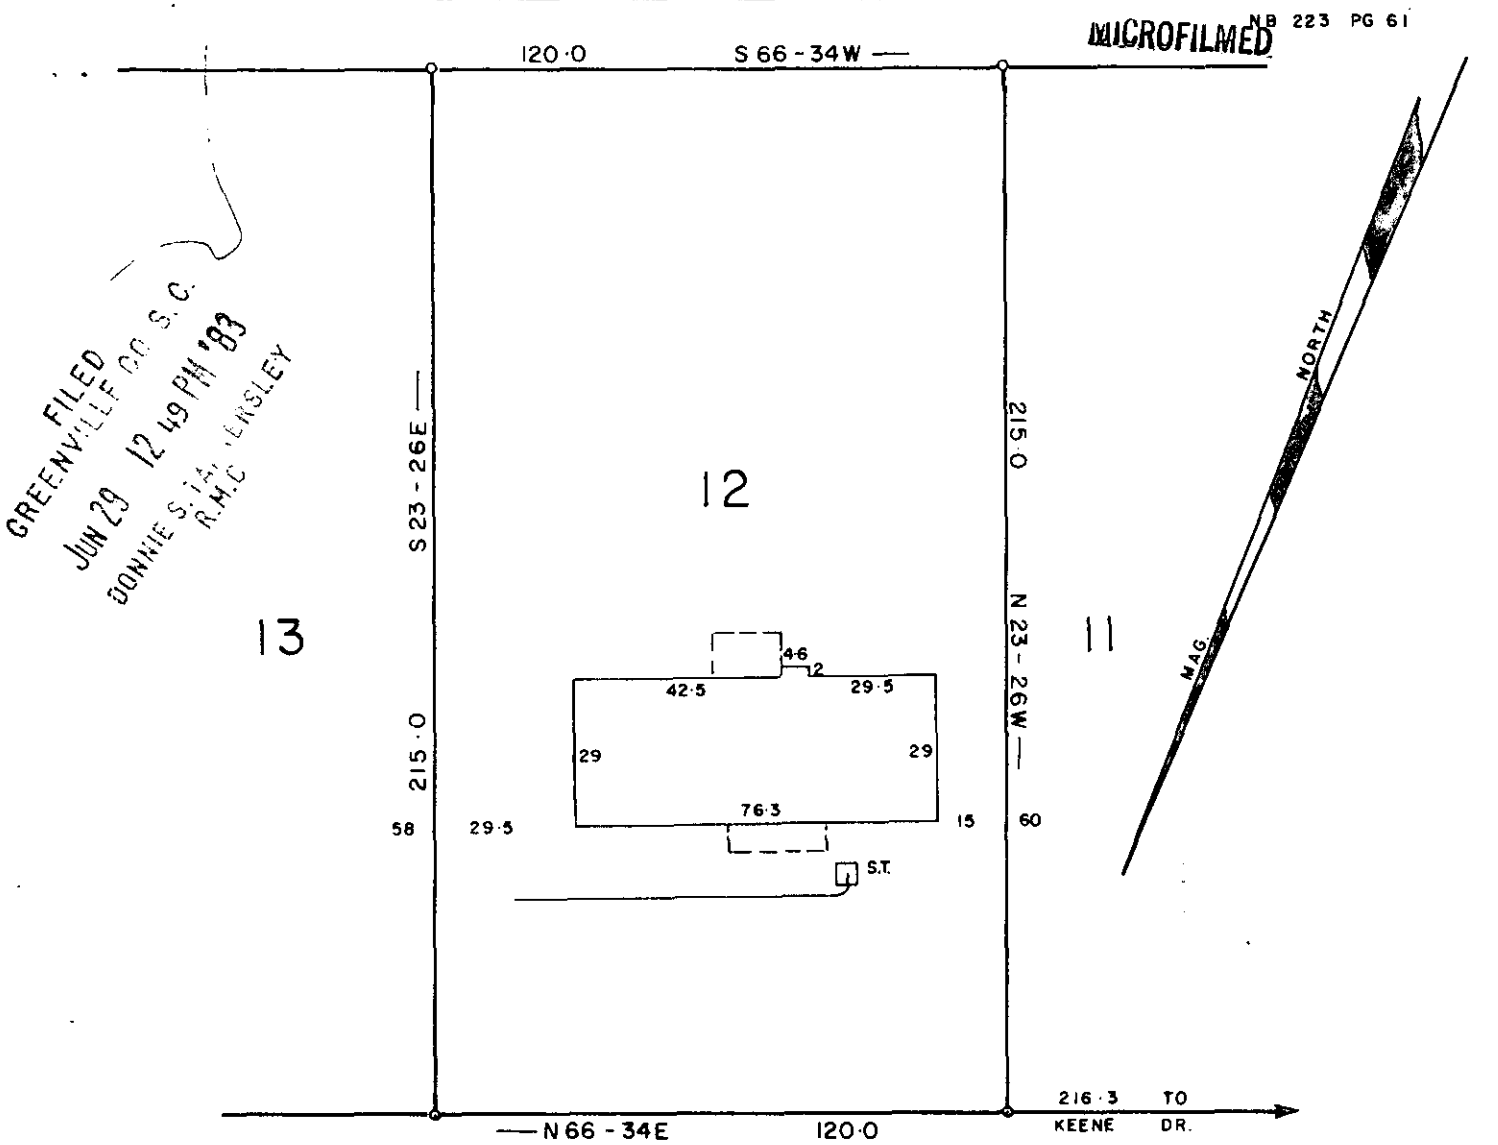

NEW PORT DR.

NOTE: THIS LOT DOES NOT LIE IN A FLOOD PLANE.

SOUTH CAROLINA REGISTERED PROFFESSIONAL ENGINEER AND LAND SURVEYOR 1144 CLIFFORD C. JONES

9-W-82

35753

JUN 29 1983

PROPERTY OF
ROBERT L. CALLISON
MARY D. CALLISON

GREENVILLE COUNTY, S. C.

JUNE - 27 - 1983

SCALE 1" = 40'

0 10 20 30 40 50 100

This is to certify that on the 27 day of JUNE 1983, I surveyed the property shown on this plat, being LOT 12 HAMPSHIRE HILLS, recorded in Plat Book 4R 44 of the R.M.C. Office for Greenville County, S. C., and that the property lines, walls and buildings are as shown hereon; that the buildings located on said lot do not encroach or project on adjacent streets or property; and that no adjacent buildings or walls encroach or project on said premises, and that no utility lines cross this property.

Reg. Engineer No. 1144 S.C.

3.00 3 46231A01

JONES ENGINEERING SERVICE 1006 E. PERRY ROAD.