SURVEY

DRAWN

CHECK

SCALE

DATE

DWG. NO."


J.E.C.

K.E.G.

6-30-83

9275

1"= 40

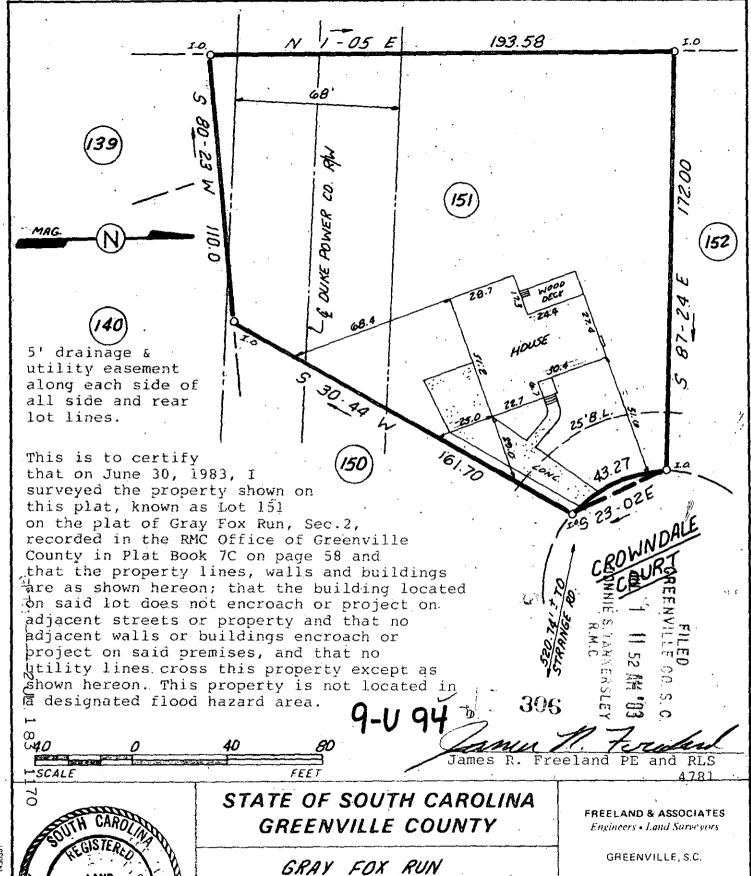

SEC. 2; LOT 151

PROPERTY OF

H. BRENT MATTOX

MATTOX

SINT MACHINE, INC. N3030

LAND

SURVÉYOR