

FILED
GREENVILLE CO. S. C.

JUL 15 4 43 PM '83

DONNIE S. TANKERSLEY
C.P.R.M.C.

195C MAG
MICROFILMED

W/R McABEE

N 30-18 E
256.2'

N 73-46 W
239.8'

S 74-14 E
179.4'

HWY. S-134

-PT 23 -


-PT 23 -

-22 -

-21 -


-20 -

NOTE: Improvements
on this lot are
not in a flood
hazard area.

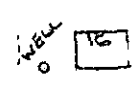

- 1.20 AC -

SEPTIC TANK
ON LOT

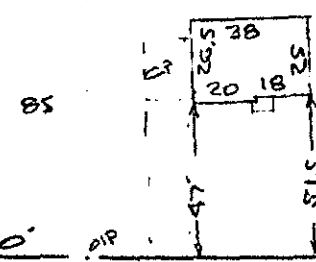

50' 200' 400'

SIG-40W 250' TOT.

MANLY ST.
WATER IN ST. R/W

PROPERTY OF
BLUDDY PHILLIPS JUL 15 1983
NEAR GREENVILLE, S.C.
60' 14 JULY 9 1983 60'

6010 --- 1 JUL 15 83 1377 3.0001

This is to certify that on the 14th day of July, 1983, I surveyed the property shown on this plat, being known as lots 21, 22, & pt. 23 on plat of WASHINGTON HUGHES and recorded in the REC Office Greenville County, S. C., in Plat Book "LL" at Page 55; and that the property lines, walls and buildings are as shown hereon, and that the walls and buildings located on said lot do not encroach or project on adjacent street or property, and that no adjacent walls or buildings encroach or project on said premises, and no power lines cross this property except as shown hereon.

9-V-41 1728

R. B. Bruckner
SOUTH CAROLINA
REGISTERED SURVEYOR
No. 185
1952

CAROLINA SURVEYING CO.
112 Manly St.
Greenville, S.C.