
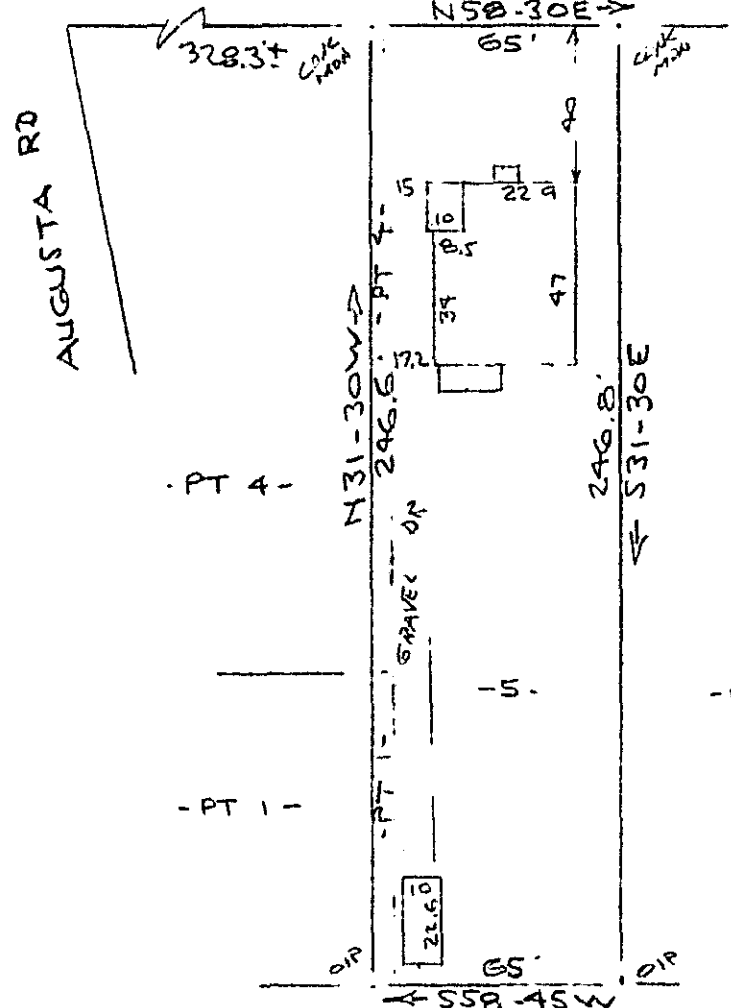


MICROFILMED

EAST AUGUSTA PLACE (ST.)  
WATER & SEWER IN ST ALW

Note: Improvements on this lot are not in a flood hazard area.

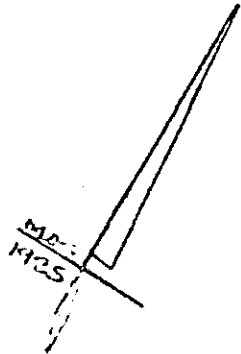

FILED  
GREENVILLE CO. S.C.  
JUL 25 12 09 PM '83  
DONNIE S. TARKERSLEY  
R.M.C.

PROPERTY OF  
ROBERT W. HAUBENREICH & ANITA J. HAUBENREICH  
GREENVILLE, S.C.  
50' 19 JULY 0 1983 50'

This is to certify that on the 19th day of July, 1983, I surveyed the property shown on this plat, being known as lot 5 and part of lot 4 and part of lot 1 on west of PROPERTY OF D. W. COCHRANE & T. C. CASS and recorded in the RMC Office Greenville County, S.C., in Plat Book "F" at Page 262 and also known as PROPERTY OF ROBERT W. HAUBENREICH & ANITA J. HAUBENREICH and recorded in Plat Book at Page ; and that the property lines, walls and buildings are as shown hereon, and that the walls and buildings located on said lot do not encroach or project on adjacent street or property, and that no adjacent walls or buildings encroach or project on said premises, and no power lines cross this property except as shown hereon.

9-V-76

2710

JUL 25 1983

CAROLINA SURVEYING CO.  
REC'D - JUL 25 83 085  
Greenville, S.C.

