


MICROFILMED

FILED
GREENVILLE CO. S. C.
JUL 29 3 40 PM '83
DONNIE S. TANKERSLEY
R.M.C.

East Stone Ave.
water & sewer in st r/w
571-50 E 55.0'

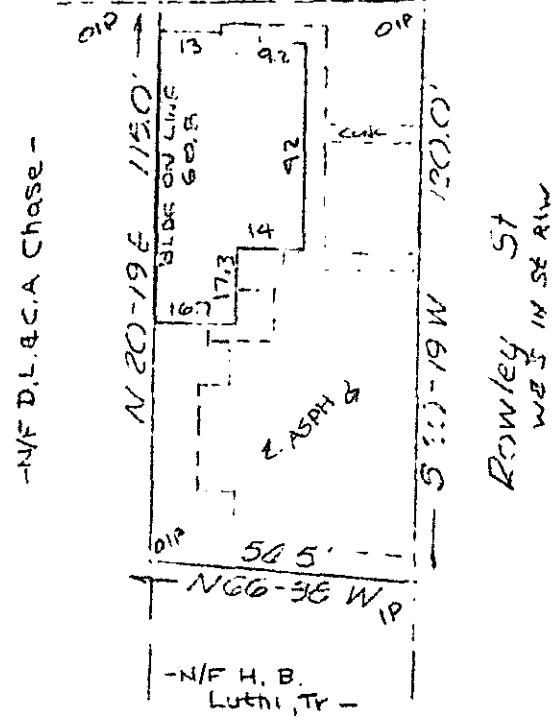

Note: Improvements on this lot are not in a flood hazard zone.

JUL 29 1983


Property of
Ronald F. Waters
Greenville, S.C.
AS 28 JULY - 1983 40'

Be it remembered that on the 28th day of July, 1983, I surveyed the property shown on this plat, being known as PROPERTY OF RONALD F. WATERS and recorded in the Public Office of Greenville County, S. C., in Plat Book _____ at Page _____. That the property lines, walls and buildings are as shown hereon, and that the same and buildings located on said lot do not encroach or project on adjacent lots or streets, and that no adjacent walls or buildings encroach or project on said property, and no power lines cross this property except as shown hereon.

9-V-95

3469 ✓

Carolina Surveying Co
116 W. Main St
Greenville, S.C.

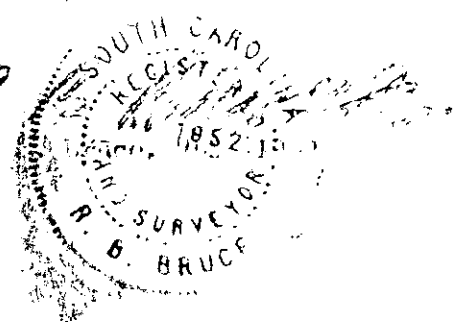

2 JUL 29 83 954 3.00CI