

FINAL PLAT

CERTIFICATE OF OWNERSHIP AND DEDICATION

The undersigned hereby acknowledge that I am (we are) the owner(s) of the property shown and described hereon and that I (we) hereby adopt this plan of subdivision with my (our) free consent and that I (we) establish the minimum building restriction lines, and hereby dedicate to public use as roads, streets, and easements, forever all areas so shown or indicated on said plat

6-30-83 Signed *Hamlin W. Barnes*
 Signed _____
 Signed _____
 Signed _____

CERTIFICATE OF ACCURACY

I, William N. Skardon, certify that this plat was (drawn by me) (drawn under my supervision) (an actual survey made under my supervision) from (an actual survey made by me) (deed description recorded in Book _____ Page _____ Book _____ Page _____ etc.) (other) that the error of closure as calculated by latitudes and departures is 1:10,000 that the boundaries not surveyed are shown as broken lines plotted from information found in Book _____ Page _____ that this plat was prepared in accordance with the Greenville County Subdivision Regulations as adopted.

30 JUNE 1983. *William N. Skardon*
 DATE LICENSED ENGINEER OR REGISTERED SURVEYOR
 S. C. Registration No. 7261

CERTIFICATE OF APPROVAL FOR RECORDING

"I hereby certify that the subdivision plat shown hereon has been found to comply with the Subdivision Regulations for Greenville County, with the exception of such variances, if any, as are noted in the minutes of the Greenville County Planning Commission of Greenville County, South Carolina, and that it has been approved for recording in the office of the County Register of Menses Conveyance."

6-30-83 *F. J. Fisher*
 DATE DIRECTOR OF PLANNING
 GREENVILLE COUNTY PLANNING COMMISSION

FILE NUMBER
82-112

CRESCENT PLACE

NOW OR FORMERLY
 — ROMAYNE BARNES —


REVISED
 6-30-83

Plat Filed This 30th day of June 1983
 And Recorded in Vol. 9-W Page 1 at 10:33 A.M.
Hamlin W. Barnes
 Register Menses Conveyance Greenville County, S. C.

9-W-1

- NOTES:
1. PLAT REVISED 8 JUNE 82 TO SHOW CHANGES IN LOTS No. 4 AND No. 5.
 2. PLAT REVISED 20 JAN. 83 TO SHOW AS BUILT LOCATION OF NEW BRICK WALL.
 3. PLAT REVISED 1 MAR. 83 TO SHOW EXTENSION OF LOT No. 3 BY 10.0' AND ENCROACHMENT OF NEW BRICK WALL ON LOTS 4 AND 5.
 4. PLAT REVISED 29 JUNE 83, TO SHOW REVISION IN COMMON LOT LINES OF LOTS 4 AND 5.
 5. THIS PROPERTY IS SUBJECT TO RESTRICTIVE COVENANTS RECORDED IN THE R.M.C. OFFICE FOR GREENVILLE COUNTY, REFERENCE TO WHICH IS HEREBY CRAVED.

Arbor Engineering, Inc.
 P.O. BOX 263, GREENVILLE, S.C.
 LANDSCAPE ARCHITECTS-ENGINEERS RECREATIONAL PLANNERS

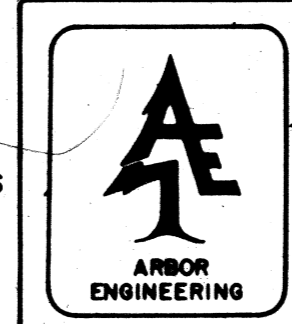

OWNER		ARBOR ENGINEERING, INC.	
SURVEYOR		SURVEYOR	
NO. OF ACRES	<u>0.94</u>	MILES NEW ROAD	<u>0</u>
NO. OF LOTS	<u>5</u>	DATE	<u>5 APRIL</u>
20 0 20 40 scale 1" = 20' feet		GREENVILLE SOUTH CAROLINA	
DRAWN	WNS	DESIGNED	ESA
CHECKED	WNS	DATE	5 APRIL 1982
SCALE	1" = 20'	FILE	82042