



JAMES F. & MERIEM P. SMITH
D.B. 1050-200
562.1-1-14.5

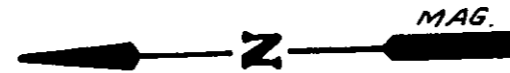

FILED
GREENVILLE CO. S. C.
JUL 28 9 08 AM '83
DONNIE S. TANKERSLEY
R.M.C.

WAMACK
D.B. 850-341
562.1-1-12.1

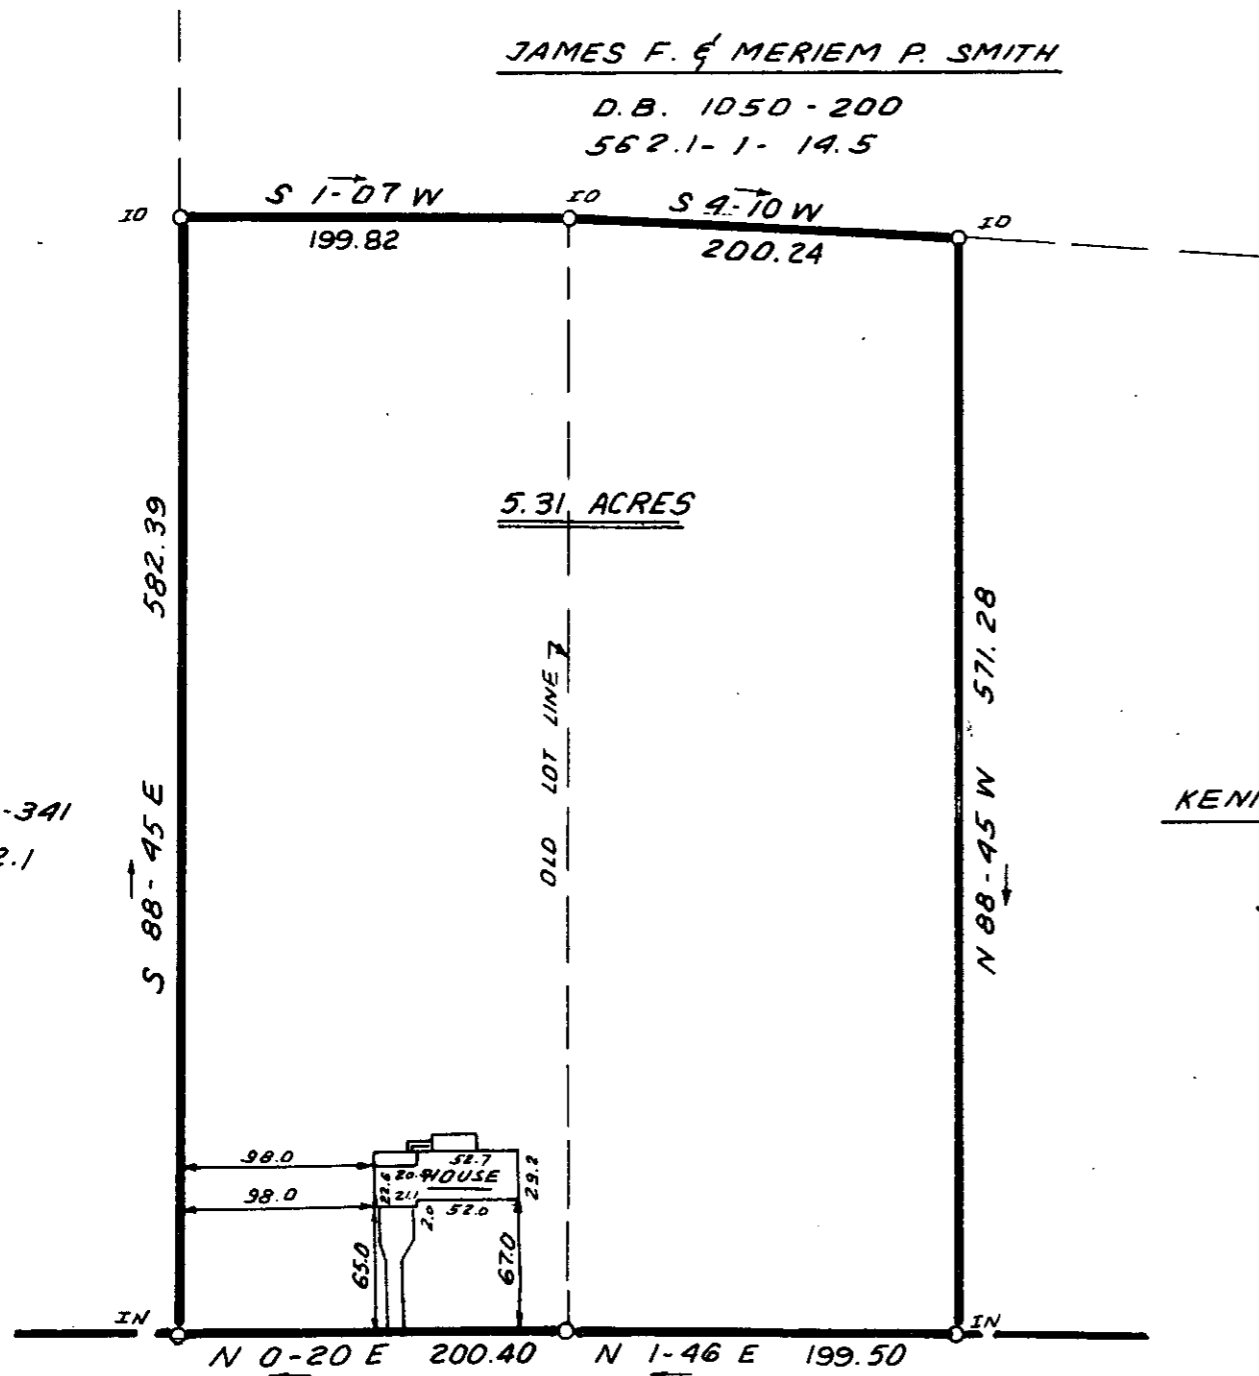

KENNETH S. & PEGGY T. WHITE
D.B. 1061-182
562.1-1-14.6

This is to certify that on June 14, 1983, I surveyed the property shown on this plat, known as the property of Herbert A. Sons and Marion J. Sons, recorded in the RMC Office of Greenville County in Deed Book 1158 on page 858 and that the property lines, walls, and buildings are as shown hereon; that the building located on said lot does not encroach or project on adjacent streets or property, and that no adjacent walls or buildings encroach or project on said premises, and that no utility lines cross this property except as shown hereon. This property is not located in a designated flood hazard area.

James R. Freeland
James R. Freeland RLS & PE 4781

TRIANGLE PINE ROAD

3128

9-X-2 ✓



STATE OF SOUTH CAROLINA
GREENVILLE COUNTY

PROPERTY OF
HERBERT A. SONS
MARIAN J. SONS

FREELAND & ASSOCIATES
Engineers • Land Surveyors

GREENVILLE, S.C.

SURVEY J.C.
DRAWN B.R.
CHECK M.C.
SCALE 1" = 100'
DATE JUNE 13, 83
DWG. NO. 9140

MICROFILMED