AF 10755A

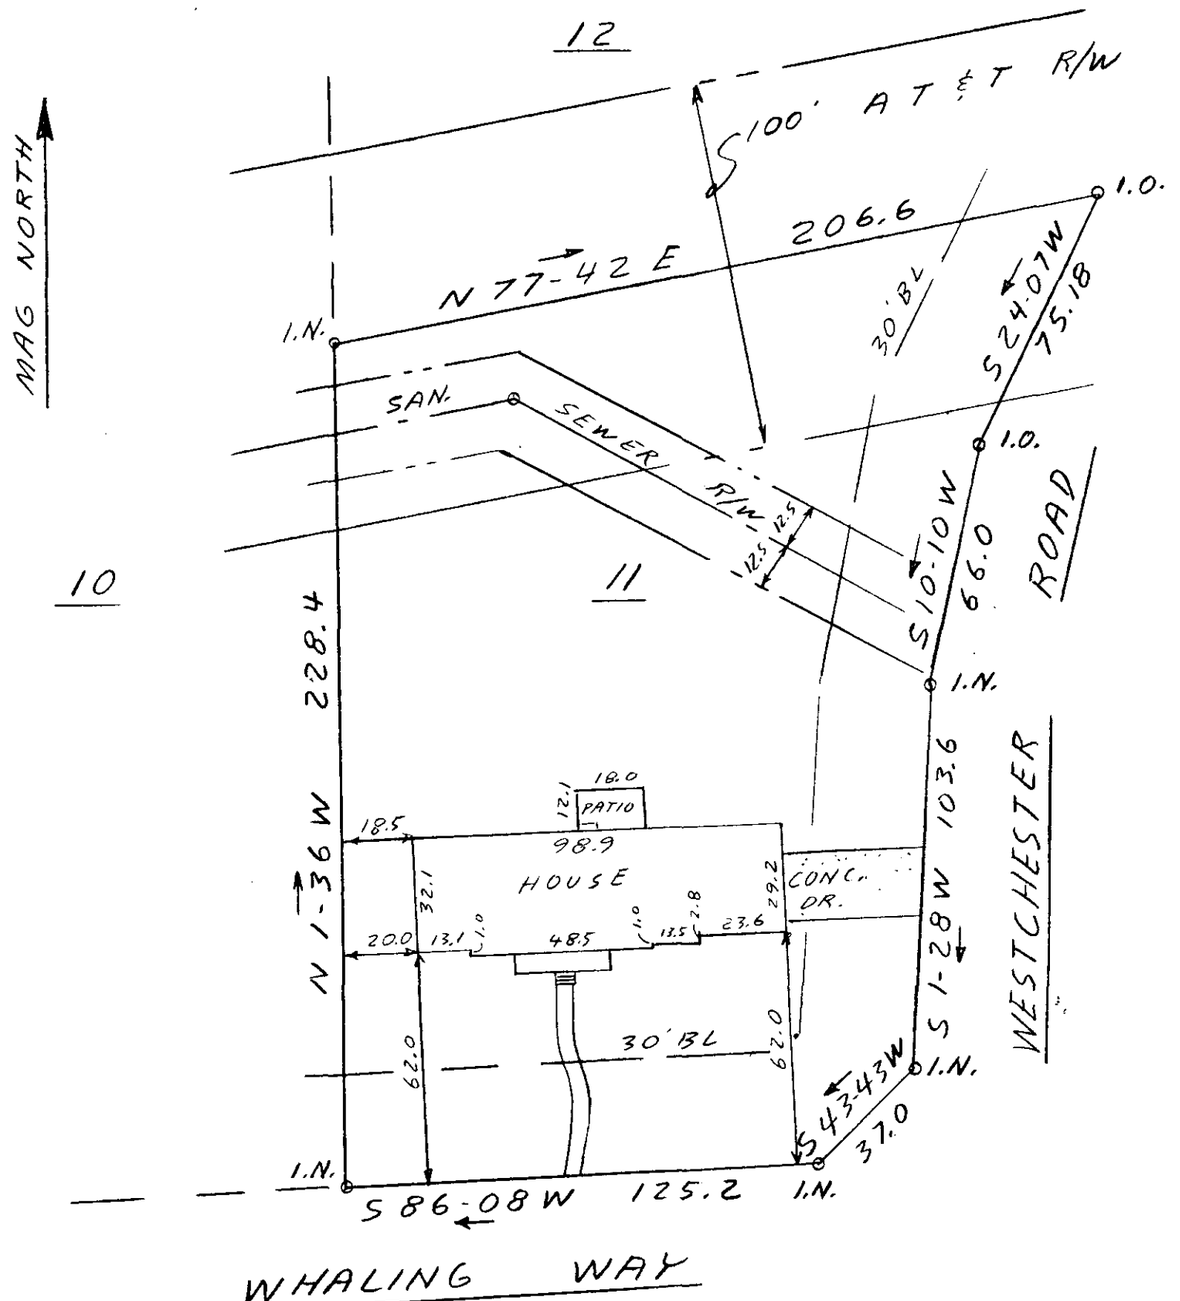

FILED
GREENVILLE CO. S. C.
AUG 1 2 47 PM '83
DONNIE S. TANKERSLEY
R.M.C.

This is to certify that on July 29, 1983, I surveyed the property shown on this plat, known as Lot 11 on the plat of Pilgrims Point, recorded in the RMC Office of Greenville County in Plat Book WWW on page 35 and that the property lines, walls and buildings are as shown hereon; that the building located on said lot does not encroach or project on adjacent streets or property and that no adjacent walls or buildings encroach or project on said premises, and that no utility lines cross this property except as shown hereon. This property is not located in a designated flood hazard area.

James R. Freeland
James R. Freeland PE and PLS 4781

3663

9-X-7

50 0 50 100
scale feet

SOUTH CAROLINA REGISTERED LAND SURVEYOR NO. 4781 JAMES RALPH FREELAND SEAL

STATE OF SOUTH CAROLINA
GREENVILLE COUNTY

PILGRIMS POINT
LOT 11
PROPERTY OF
LINDA S. PALMER

FREELAND & ASSOCIATES
Engineers • Land Surveyors
GREENVILLE, S.C.

SURVEY	H B
DRAWN	J R F
CHECK	M. C.
SCALE	1" = 40'
DATE	7-29-83
DWG. NO.	83-9453

MICROFILMED

5.00 3 51471A01