

S.C. HWY. # 253

N 53-42E 233.94

FILED  
GREENVILLE S.C.  
AUG 5 10 21 AM '83  
DONNIE S. TANKERSLEY  
R.M.C.


J.T. YOUNG



This is to certify that on August 3, 1983, I surveyed the property shown on this plat, known as the property of Allan L. and Frankie M. Russo, recorded in Deed Book 1138 on page 304 and that the property lines, walls and buildings are as shown hereon; that the building located on said lot does not encroach or project on adjacent streets or property and that no adjacent walls or buildings encroach or project on said premises, and that no utility lines cross this property except as shown hereon. This property is not located in a designated flood hazard area.

*James R. Freeland*  
James R. Freeland RLS & PE 4781

1.60 AC.

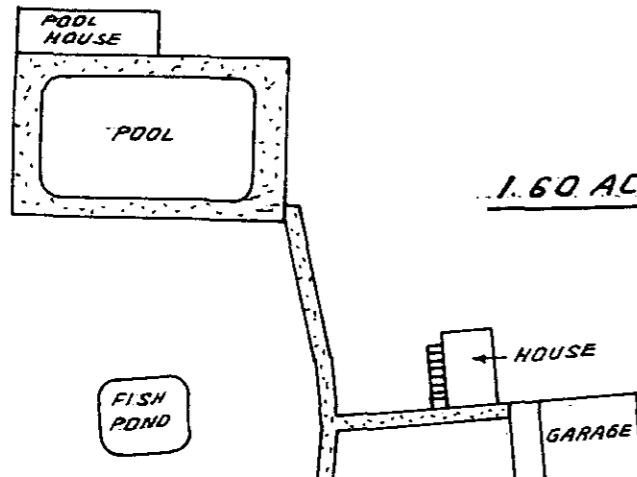

N 42-35 W 311.35

S 42-32 E 288.24

W. H. HARMON JR.

5.001D  
3 AUG 5 83 065

L.G. DSTEEN

9-X-13 ✓


AUG 5 1983

4300

10.59'± TO FRANKLIN RD.

CLARENDON AVENUE

S 48-02 W 232.27

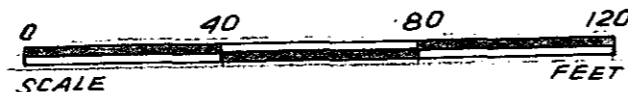

STATE OF SOUTH CAROLINA  
GREENVILLE COUNTY

PROPERTY OF  
ROLF W. HEMMERLING  
MARJORIE E. HEMMERLING

FREELAND & ASSOCIATES  
Engineers • Land Surveyors

GREENVILLE, S.C.

SURVEY J.E.C.  
DRAWN B.R.  
CHECK M.C.  
SCALE 1" = 40'  
DATE AUG. 3. 83  
DWG. NO. 9499

MICROFILMED